


HINDS
 H172
 E Log # 705
 2/2/81
 Feb. 2

MISSISSIPPI
 BOARD OF WATER COMMISSION
 416 North State Street
 Jackson, Mississippi 39201
 WATER WELL DRILLERS LOG

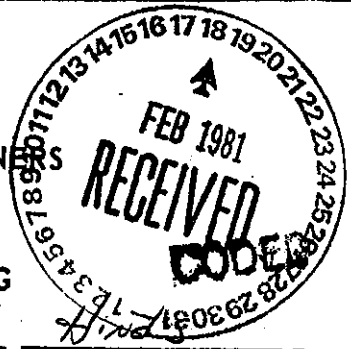

1981 F.M. "Bud" CRESSWELL
 date well completed firm name county well located

LANDOWNER:
 Speery-Vickers
 JACKSON, MS.
 (mailing address)

WELL LOCATION:
 sec. 11 T. 6 N R. 1 E
 JACKSON
 (distance) miles (direction) of (nearest town)

description of formations encountered	from	to
Clay	0	120
Hard Shale	120	340
Sand	340	360
Shale	360	750
Sand	750	780
Shale	780	830
Sand	830	920

WELL PURPOSE: Industrial
 (home, irrigation, municipal, industrial)

WELL COMPLETION DATA:

(1) diameter (inches) 4

(2) total depth (feet) 920

(3) static water level (feet) 240 below top of ground.

(4) casing Steel 880 (material) (depth)
 4 (size) If telescope see back.

(5) screen 40 880 (length) (depth to top)
 2 1/2 Drilled (size) (material)

(6) pump 5 45 (HP) (yield gpm)

(type power)

(7) electric log Yes (yes or no)
 Mr. Kate DeFavey (organization running log)

(8) how well bottom plugged
 Back wash valve

DRILLERS REMARKS:

