

06/03/2008 12:24 6528410251

TOTAL: SERVICE

PAGE 02/11

05/19/2008 10:25 6528410251  
MDEQ-08 08:00 MDEQ-LAND & WATER

TOTAL: SERVICE  
001-004-0000

PAGE 07/09  
T-044 P.00 F-442

County Hinds  
 Permit # \_\_\_\_\_  
 Station Jerry Bayles  
 Date of last compliance 5-1-07

**State Well Report**  
**Part I - Driller's Log**  
 Mississippi Department of Environmental Quality  
 Office of Land and Water Resources  
 P.O. Box 1001  
 Jackson, MS 39202-0001  
 (601) 901-0330  
 (800) 354-6938 (Toll)

For Office Use Only  
 Agency H-221  
 Well # \_\_\_\_\_  
 L.S. Number \_\_\_\_\_  
 Date \_\_\_\_\_

*Note: Law requires that this report be prepared by the license holder responsible for the well and filed with the Department of the state within 30 days of completion of drilling of the well or hydraulic fracturing.*

**Information on Well Owner**  
 (Licensee of records to be filed on every well)  
 Owner Name Carol Biedenbach  
 Mailing Address 4028 Eaton Rd  
Jackson  
MS 39216  
 City State Zip Code

**Well or Hydraulic Location**  
 Latitude 32° 27' 15.2" Longitude 90° 43' 57.1"  
32° 20' 49" 90° 09' 37"  
 Method of Locating (check one):  Aerial Survey  
 GPS (check one)  Survey  
 N. \_\_\_\_\_ S. 23 T. 6 N R. 16  
 Section \_\_\_\_\_ Township \_\_\_\_\_ Range \_\_\_\_\_  
 Just off. int. in town of Spokane

Date drilling started 5-5-07 Date drilling completed 5-2-07 Well depth 225 ft Well diameter 4 1/2"

Location of the source of any surface water used in drilling \_\_\_\_\_  
 Method of testing and volume of Chemical used in drilling and development \_\_\_\_\_

Log run (check all applicable): No log run Electric Loggers Log Density Logs Neutron Logs  
 Name of organization making log(s) \_\_\_\_\_

Purpose of Well (check one): Water Well \_\_\_\_\_ Geotechnical/Geological Investigation \_\_\_\_\_ Ground Source Heat Pump   
 Other (describe) \_\_\_\_\_

Purpose of Well (check one): Mine \_\_\_\_\_ Industrial \_\_\_\_\_ Public Supply \_\_\_\_\_ Irrigation \_\_\_\_\_ Fire Protection \_\_\_\_\_ Other \_\_\_\_\_

If a drinking well, method of flow regulation: Valve \_\_\_\_\_ Other (describe) \_\_\_\_\_

Static Water Level: \_\_\_\_\_ feet above or below (check one) land surface \_\_\_\_\_ feet above \_\_\_\_\_

Method of Measurement (check one) and type \_\_\_\_\_ check type of the \_\_\_\_\_ other \_\_\_\_\_

Well depth: \_\_\_\_\_ Well grouted to a depth of \_\_\_\_\_ feet Type of grout (check one) Non-Cement Grout/Cement Grout  
 Casing length \_\_\_\_\_ feet Casing diameter \_\_\_\_\_ inches Type of casing \_\_\_\_\_  
 Screen length \_\_\_\_\_ feet Screen diameter \_\_\_\_\_ inches Type of screen \_\_\_\_\_  
 Screen slot size \_\_\_\_\_ inches Setting depth from \_\_\_\_\_ feet to \_\_\_\_\_ feet

Type of completion (check all applicable): Gravel packed Unfinished Tolerated Openhole Natural Development  
 Other (describe) \_\_\_\_\_

Top of the pipe or casing to casing \_\_\_\_\_ feet

*Wanna G  
 Red Ridge*

I could not find this one  
 New Const.

RECEIVED  
 MAY 20 2008  
 BY: OLWR



06/03/2008 12:24

6628410251

TOTAL: SERVICE


PAGE 04/11

# Total Service Company, Inc. H-221

Brenda Danforth  
Owner

425 Hallman Trail  
Pontotoc, MS 38663  
662-841-0251 Office  
Woman Owned Business


Fred Danforth  
CEO

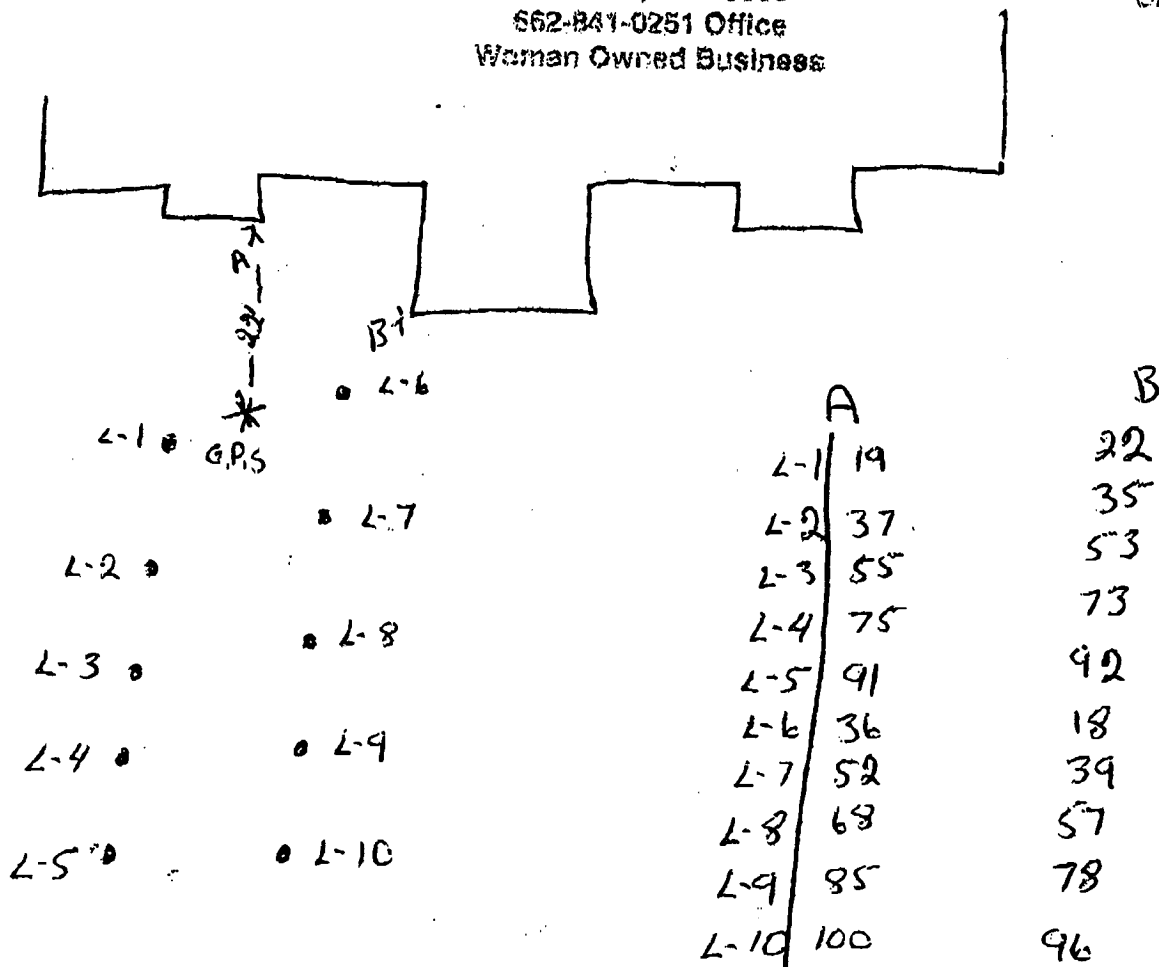

G.P.S.

~~32° 27' 33" N~~ 32 20 44  
~~090° 43' 57" W~~ 90 09 37

Jackson Miss.  
Hinds county

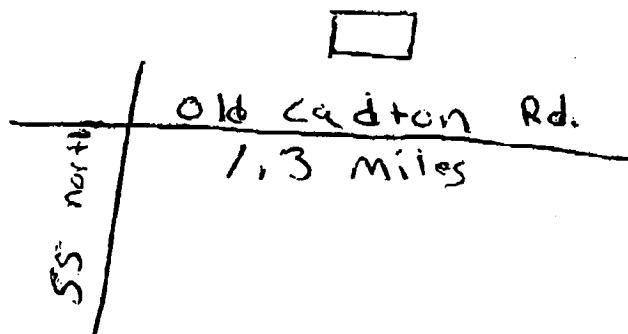

Send To Printer    Back To TerraServer    Change to 8.5x11 Print Size    Show Grid Lines    Change to Landscape  
USGS Jackson, Mississippi, United States 01 Jul 1998

