

HINDS

MISSISSIPPI BOARD OF WATER COMMISSIONERS

H 2000

7-31-62

WATER WELL DRILLERS LOG

Date: 7-31, 1962, Driller: James McNeese County Hinds

(Name)

(1) Owner of Land: Nick Ousley  
 (Name)  
Tougaloo Miss P.O. Box 12  
Shrader 2nd Sub.  
 (2) Location: 1/4, 1/4, Sec. 6 W R 1E  
3 miles North of Jackson  
 (distance) (direction) (Nearest Town)  
 (3) Topography:  (Hilly)  (Flat)  (Level)  
 (4) Purpose of Well: Domestic Home  
 (Domestic Irrigation, Municipal, Industrial, Other)

Description & Color of Materials Sand, Clay, Red Clay, Shell, etc.	Thick- ness Feet	Depth Feet
Surface soil	10	10
Yellow clay	20	30
Blue shale	269	299
Rock	1	300
Sand - sh stks	14	314
Grey shale	26	340
Grey sh - 2d stks	20	360
Sand - Grey sh stks	40	400
Grey shale	40	440
Grey shale lignite	20	460
Grey shale	6	466
Sand	84	550
Grey sh sd stks	10	560
Grey shale	17	577
15 Jts 4"	312	6
1 4" coupling and 4" x 2" swedge	1	
9 Jts 2"	189	6
1 - -	15	6
2 - 2".008 stainless steel screens	538	0
1 2" Tail pipe	5	0
1 2" Coupling	543	0
B.P.V and Nipple	1	0
	544	0


Information upon completion of well:

(1) Diameter 4" x 2" inches.  
 (2) Total Depth 577 feet. 538  
 (3) Water Level 176 feet below top of ground.  
 (4) Cased to 518 feet, Size 4 x 2"  
 (5) Screen: Size 2".008, Length 20  
 (6) Were any formations sealed against pollution?  
 yes,  no.

If YES depth of formation

Why

Drillers Remarks:

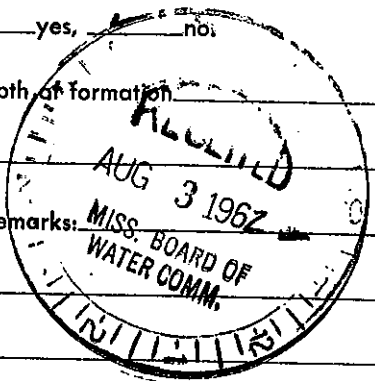

(Use Back Side)

Well No.

Mail this copy to Board of Water Commissioners 429 Miss. St. Jackson, Miss