

HINDS

H 2001

8-27-62

WATER WELL DRILLERS LOG

Forest Drilling

Date: 8/24 to 8/27, 1962, Driller: Johnnie Beasley County: Hinds

(Name)

(1) Owner of Land: W J D X Radio Stat. (Name)

Jackson, Miss. (Address)

This well located on Beasley Rd. (2) Location: 1/4, 1/4, Sec. 10, R. 1E in North Jackson. At radio towers.

miles of (distance) (direction) (Nearest Town)

(3) Topography: x (Hilly) (Flat) (Level)

(4) Purpose of Well: Domestic Home (Domestic Irrigation Municipal, Industrial, Other)

Information upon completion of well:

- (1) Diameter: 2 inches.
(2) Total Depth: 697 feet.
(3) Water Level: 150 feet below top of ground.
(4) Cased to: 677', Size 2".
(5) Screen: Size 2", Length 20'.
(6) Were any formations sealed against pollution? yes, x no.

If YES depth of formation


Why

Drillers Remarks: Good well.

Table with 3 columns: Description & Color of Materials, Thickness Feet, Depth Feet. Rows include: Brown silt & clay, Blue clay, Shale & stks. lime, Shale, shell & lignite, Shale, soft clay & lignite, Shale & stks. sand, Fine sand. FINE SAND (Poor), Fine sand & stks. shale, Fine sand. (Poor.), Fine sand & stks. shale, Shale, Silt & shale, Sand. (Screen setting.)

FOREST DRILLING SERVICE

P. O. Box 5717 PEARL BRANCH JACKSON 8, MISS.

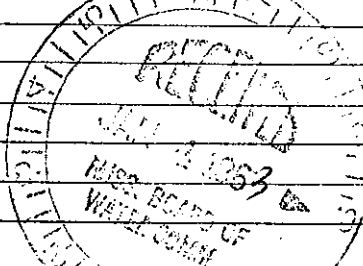

(Use Back Side)

Well No.

Retain this copy for your office files.