

HINDS

H 2003

WATER WELL DRILLERS LOG

Hinds

4-15-63

Date: 4/15, 1963, Driller: Frank Dalg. Int. County: Franklin

(1) Owner of Land: A. M. Myles
 #3
Jackson Miss.
 (Name)
 (Address)

(2) Location: 1/4, 1/4, Sec. TWR 112
3 miles West of Jugosa.
 (distance) (direction) (Nearest Town)
College

(3) Topography: _____
 (Hilly) (Flat) (Level)

(4) Purpose of Well: _____
 (Domestic Irrigation
 Municipal, Industrial, Other)

Description & Color of Materials Sand, Clay, Red Clay, Shell, etc.	Thick- ness Feet	Depth Feet
<u>Chalky Clay</u>	<u>0</u>	<u>28</u>
<u>Blue Clay (soft)</u>		<u>214</u>
<u>Blue Shale</u>		<u>390</u>
<u>Thin Shale</u>		<u>420</u>
<u>Shale + 1/4" Lignite</u>		<u>445</u>
<u>Shale + 1/4" Sand</u>		<u>471</u>
<u>Shale</u>		<u>538</u>
<u>Fine Sand</u>		<u>553</u>
<u>Shale</u>		<u>573</u>
<u>Shale + 1/4" Silt</u>		<u>600</u>
<u>Fine Sand + Silt</u>		<u>617</u>
<u>Sand + 1/4" Shale</u>		<u>648</u>
<u>Fine Sand</u>		<u>682</u>

Information upon completion of well:

(1) Diameter 2" inches.

(2) Total Depth 682 feet.

(3) Water Level 192 feet below top of ground.

(4) Cased to 667, Size 2"


(5) Screen: Size 2", Length 15ft.

(6) Were any formations sealed against pollution?
 _____ yes, X no.

If YES depth of formation _____

Why _____

Drillers Remarks: _____

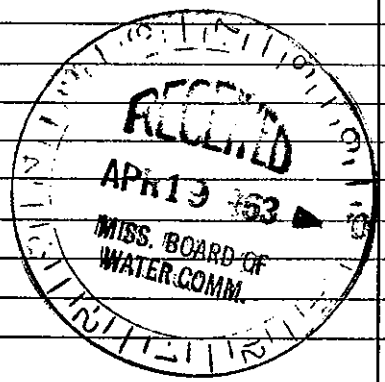

Well No.

(Use Back Side)

Retain this copy for your office files.