

HINDS MISSISSIPPI BOARD OF WATER COMMISSIONERS

H 2004


7-29-63

WATER WELL DRILLERS LOG

Hinds
Scott

Date: 7-29, 1963, Driller: Frost Dalg SW County: Scott
(Name)

(1) Owner of Land: _____ (Name)	Description & Color of Materials Sand, Clay, Red Clay, Shell, etc.	Thick- ness Feet	Depth Feet
<u>D. L. Peterson</u> <u>Rt 4 Box 164 Jackson</u> (Address)	<u>Brown silt</u> <u>Blue clay</u> <u>Sand</u>	<u>0</u>	<u>17</u> <u>40</u> <u>48</u>
(2) Location: _____ 1/4, _____ 1/4, Sec. <u>6 R 1 E</u>			
<u>2</u> miles <u>East</u> of <u>air port</u> (distance) (direction) (Nearest Town) <u>Jackson</u>			
(3) Topography: <input checked="" type="checkbox"/> (Hilly) <input type="checkbox"/> (Flat) <input type="checkbox"/> (Level)			
(4) Purpose of Well: <u>Home</u> (Domestic Irrigation Municipal, Industrial, Other)			
Information upon completion of well:			
(1) Diameter <u>2</u> inches.			
(2) Total Depth <u>48</u> feet.			
(3) Water Level <u>12</u> feet below top of ground.			
(4) Cased to <u>42</u> , Size <u>2"</u>			
(5) Screen: Size <u>2"</u> , Length <u>6ft.</u>			
(6) Were any formations sealed against pollution?			
_____ yes, <input checked="" type="checkbox"/> no.			
If YES depth of formation _____			
Why _____			
Drillers Remarks: _____			

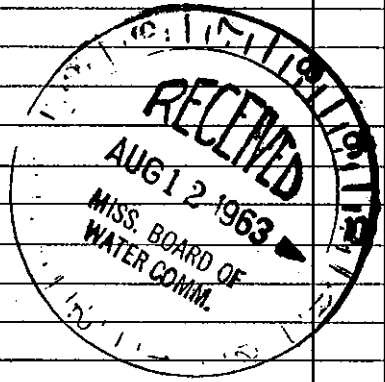

Well No.

(Use Back Side)

Mail this copy to Board of Water Commissioners 429 Miss. St. Jackson, Miss.