

STATE BOARD OF WATER COMMISSIONERS

HINDS

WATER WELL DRILLERS LOG

H 2008
6-9-64

Date: 6-9-1964, Driller: Cross and Crosswell County Hinds

(Name)

(1) Owner of Land: PERKINS
(Name)

JACKSON MISS.
(Address)

(2) Location: WEST CAPITOL
ALABAMA AVE.
miles (distance) 1/4 Sec. T2N R1E of (Nearest Town)

(3) Topography: FLAT
(Hilly) (Flat) (Level)

(4) Purpose of Well: Commercial
(Domestic Irrigation, Municipal, Industrial, Other)

Description & Color of Materials
Sand, Clay, Red Clay, Shell, etc.

Thick-
ness
Feet

Depth
Feet

<u>YELLOW CLAY</u>	<u>40</u>	<u>40</u>
<u>BLUE</u>	<u>60</u>	<u>100</u>
<u>GREY SHALE</u>		
<u>STR. SAND</u>	<u>260</u>	<u>360</u>
<u>GREY SAND</u>	<u>60</u>	<u>420</u>
<u>SHALE BROWN</u>	<u>140</u>	<u>560</u>
<u>SAND GOOD</u>	<u>90</u>	<u>650</u>
<u>SDY. SHALE</u>	<u>10</u>	<u>660</u>

Information upon completion of well:

(1) Diameter: 4 1/2 inches. well 3 7/8"

(2) Total Depth: 660 feet. hold depth

(3) Water Level: 240 feet below top of ground.

(4) Cased to: 357, Size 4"

(5) Screen: Size: 008, Length: 20

(6) Were any formations sealed against pollution?


_____ yes, _____ no.

If YES depth of formation _____

Why _____

Drillers Remarks: 2 H-p. pump

220 GAL. TANK

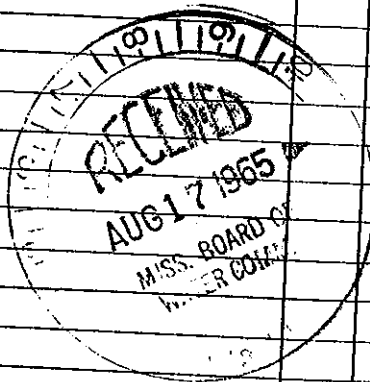

Well No.

(Use Back Side)

Mail this copy to Board of Water Commissioners 429 Miss. St. Jackson, Miss.