

HINDS MISSISSIPPI BOARD OF WATER COMMISSIONERS


H 2007  
6-24-64

WATER WELL DRILLERS LOG

Hinds

Date 6/24, 1964, Driller: Paul Dalg Sec County Hinds  
(Name)

(1) Owner of Land:	Description & Color of Materials Sand, Clay, Red Clay, Shell, etc.	Thick- ness Feet	Depth Feet
Con - Ply, Inc. P.O. Box 4327 Jackson, Miss. (Address)	Silt + clay clay		36
(2) Location: 1/4, 1/4, Sec. 1	Blue Clay		245
On old Hwy 51 north	Shale		290
Miles north of Jackson	Rock		303
(3) Topography:	Shale + sth rock		350
(4) Purpose of Well: <u>2nd</u>	Shale, lignite + sand		308
Information upon completion of well:	Fine sand		376
(1) Diameter <u>4 x 2 1/2</u> inches.	Shale		409
(2) Total Depth <u>962</u> feet.	Silt + sth silt		429
(3) Water Level <u>200</u> feet below top of ground.	Fine sand		471
(4) Cased to <u>700</u> , Size <u>3 3/4" x 4"</u>	Sand + sth shale		493
(5) Screen: Size <u>3 3/4"</u> , Length <u>20 ft.</u>	7. Sand		575
(6) Were any formations sealed against pollution?	Silt, lignite + silt		534
yes, <input checked="" type="checkbox"/> no.	Silt + sth silt		554
If YES depth of formation _____	7. Sand + sth shale		600
Why _____	Shale		670
Drillers Remarks: _____	Rock		675
_____	Hard shale + sth rock		717
_____	Hard shale		731
_____	Rock		734
_____	Shale		738
_____	Rock, Shale		759
_____	Silt + sth rock		780
_____	Shale		800
_____	Sth shale + 7 sand		810
_____	7 sand		841
_____	Silt + sth		883
_____	Silt + sth		905
_____	Shale		920
_____	Rock		923
_____	Silt + sth		927
_____	Silt + sth		962

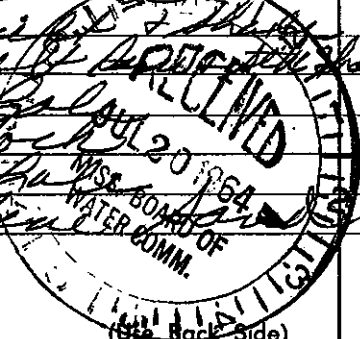

Well No.

Mail this copy to Board of Water Commissioners 429 Miss. St. Jackson, Mis: