

HINDS

H 7008

6-25-64

MISSISSIPPI BOARD OF WATER COMMISSIONERS

WATER WELL DRILLERS LOG

Date: 6/25, 1964, Driller: M Key

County: Hinds

(1) Owner of Land: Miss Water Co.

Jackson (Address)

(2) Location: SW SE NE 1/4, 1/4, Sec 27 T6N R1E, Cor. of Mitchell & Windsor St

(3) Topography: (Hilly) (Flat) (Level)

(4) Purpose of Well: (Domestic Irrigation) (Municipal, Industrial, Other)

Information upon completion of well:

(1) Diameter: 4x2 inches.

(2) Total Depth: 7.50 feet.

(3) Water Level: 218 feet below top of ground.

(4) Cased to: 716, Size

(5) Screen: Size 007, Length 40.

(6) Were any formations sealed against pollution?


yes, no.

If YES depth of formation

Why

Drillers Remarks: 360

Description & Color of Materials Sand, Clay, Red Clay, Shell, etc.	Thick- ness Feet	Depth Feet
White Clay	0	10
White Clay	10	20
Blue Clay	20	40
Blue Clay	40	60
Rock Str Clay	60	80
Blue Clay	80	100
Brown Clay	100	120
Blue Clay	120	140
Blue Clay Rock Str	140	160
Blue Clay	160	180
Blue Clay	180	200
Blue Clay	200	220
Blue Clay	220	240
Blue Clay - Shale	240	260
Shells - Sand	260	420
Sandy Clay	420	440
Sandy Clay	440	460
Sandy Clay	460	520
Sandy Clay	520	540
Sandy Clay	540	560
Sandy Clay	560	620
Fine Sand	620	680
med Sand	680	700
	700	750

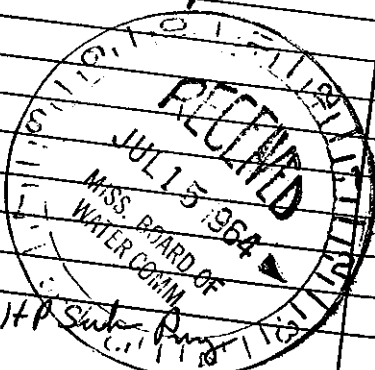

1 1/2 HP Sinter Pump

Well No.

(Use Back Side)

this copy to Board of Water Commissioners 429 Miss. St. Jackson, Miss