

Hinds MISSISSIPPI BOARD OF WATER COMMISSIONERS

H 2011

4-66

WATER WELL DRILLERS LOG

Date: 4-15, 1966, Driller: HALL DRILLING CO County HINDS

(Name)

(1) Owner of Land:	Description & Color of Materials Sand, Clay, Red Clay, Shell, etc.	Thick- ness Feet	Depth Feet
<u>HINDS COUNTY WATER CO</u> (Name)	<u>SURFACE SOIL</u>	<u>9</u>	<u>9</u>
<u>JACKSON MISS</u> (Address)	<u>YELLOW MARL</u>	<u>36</u>	<u>45</u>
(2) Location: <u>NW 1/4</u> , <u>1/4</u> , Sec. <u>7</u> T <u>6</u> N R <u>2</u> E,	<u>YAZOO CLAY</u>	<u>340</u>	<u>385</u>
<u>2</u> miles <u>NORTH</u> of <u>JACKSON</u> ,	<u>MOODY BRANCH</u>	<u>23</u>	<u>408</u>
(distance) (direction) (Nearest Town)	<u>STREAKS FINE SAND +</u>	<u>-</u>	<u>-</u>
(3) Topography: <u>FLAT</u>	<u>HARD SHALE</u>	<u>167</u>	<u>576</u>
(Hilly) (Flat) (Level)	<u>SAND SHALE + LIC</u>	<u>60</u>	<u>635</u>
(4) Purpose of Well: <u>MUNICIPAL</u>	<u>COURSE SAND</u>	<u>40</u>	<u>670</u>
(Domestic Irrigation Municipal, Industrial, Other)	<u>SHALE SAND + LIC</u>	<u>12</u>	<u>682</u>

Information upon completion of well:


- (1) Diameter 4 X 2 1/2 inches.
- (2) Total Depth 682 feet.
- (3) Water Level 219 feet below top of ground.
- (4) Cased to 400 652, Size 4
252' - 2 1/2
- (5) Screen: Size 2 1/2, Length 30
- (6) Were any formations sealed against pollution?
yes, no.

If YES depth of formation _____

Why _____

Drillers Remarks: TOP 80'

CEMENTED

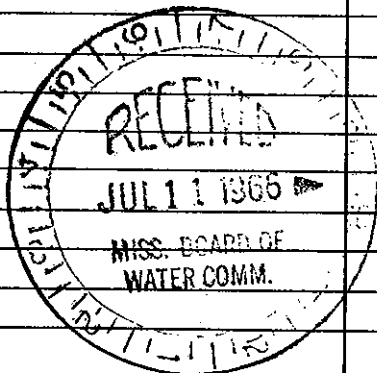

27

Well No.

(Use Back Side)

this copy to Board of Water Commissioners 429 Miss. St. Jackson, Miss.