

HINDS

MISSISSIPPI BOARD OF WATER COMMISSIONERS

H 2012

4-11-66

WATER WELL DRILLERS LOG

Date: 4/11, 1966, Driller: Faust Drilling Co. (Name)

(1) Owner of Land: (Name)	Description & Color of Materials Sand, Clay, Red Clay, Shell, etc.	Thick- ness Feet	Depth Feet
Humble Oil Co. Jackson, Miss	Brown silt & clay		40
at intersection of Hwy 55 & old rd 51 - north side	Blue clay		266
(2) Location: 1/4 Sec. 16, T. 16 N., R. 1 E.	Grey shell & lignite		286
miles of (distance) (direction) of (Nearest Town)	Shale & silt		389
(3) Topography: (Hilly) (Flat) (Level)	Fine sand		400
(4) Purpose of Well: (Domestic Irrigation) (Municipal, Industrial, Other)	Sand & silt shale		412
	Fine sand		511
	Fine sand & lignite		530
	Shale & lignite		552
	Shale & silt sand		576

Information upon completion of well:


- (1) Diameter 4x2 inches.
- (2) Total Depth 553 feet.
- (3) Water Level 140 feet below top of ground.
- (4) Cased to 197 ft, Size 4 1/2" (533 ft)
- (5) Screen: Size 2, Length 20 ft.
- (6) Were any formations sealed against pollution?  yes,  no.

If YES depth of formation

Why

Drillers Remarks:

Good well

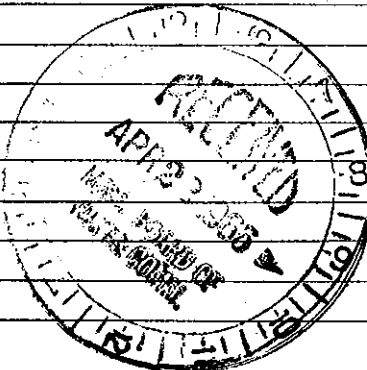

(Use Back Side)

Well No.