

HINDS  
J  
2-61

MISSISSIPPI BOARD OF WATER COMMISSIONERS

WATER WELL DRILLERS LOG

J 300

Date: FEB, 1961, Driller: MSNEECE DRILLING Co. County HINDS

(Name)

(1) Owner of Land: REDFIELD ESTATE (Name)	Description & Color of Materials Sand, Clay, Red Clay, Shell, etc.	Thick- ness Feet	Depth Feet
EDWARDS, MISS. (Address)	CLAY SOIL	17	0
(2) Location: SW 1/4, SE 1/4, Sec. 4 T5R4W	GRAVEL	6	17
5 miles SOUTH, of EDWARDS (distance) (direction) (Nearest Town)	WHITE SHALE	22	23
(3) Topography: HILLY (Hilly) (Flat) (Level)	GREY SHALE	73	45
(4) Purpose of Well: CATTLE & HOG FARM (Domestic Irrigation Municipal, Industrial, Other)	ROCK LEDGES	50	118
	GREY SHALE	130	168
	SAND	44	298
	SHALE (GREY)	21	342
			363


Information upon completion of well:

- (1) Diameter 4x2 inches.
- (2) Total Depth 363 feet.
- (3) Water Level 103 feet below top of ground.
- (4) Cased to 253, Size 4"  
253 - 363 - 2"
- (5) Screen: Size 2", Length 40'
- (6) Were any formations sealed against pollution?  
\_\_\_\_\_ yes,  no.

If YES depth of formation \_\_\_\_\_

Why \_\_\_\_\_

Drillers Remarks: \_\_\_\_\_

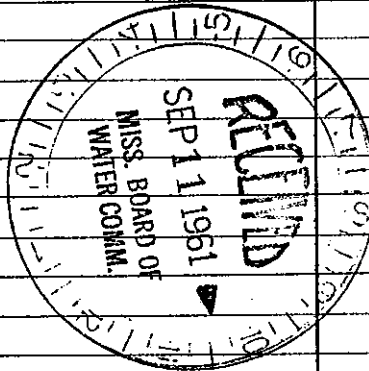

Well No.  
12

(Use Back Side)

Mail this copy to Board of Water Commissioners 429 Miss. St. Jackson, Miss