

HINDS
J 32
6-29-64

MISSISSIPPI BOARD OF WATER COMMISSIONERS

WATER WELL DRILLERS LOG

CODED

Hinds
Hinds


Date: 6/29/1964, Driller: Jaust Drilling County: Hinds
(Name)

(1) Owner of Land:	Description & Color of Materials Sand, Clay, Red Clay, Shell, etc.	Thick- ness Feet	Depth Feet
(Name) <u>Adamp Buttry</u> <u>Edwards Miss.</u>	<u>Brown silt</u>	<u>0</u>	<u>18</u>
(Address)	<u>Gravel</u>		<u>22</u>
(2) Location: $\frac{1}{4}$, $\frac{1}{4}$, Sec. <u>15N 4W</u> T R	<u>Chalk, lime & shale</u>		<u>53</u>
<u>5</u> miles <u>S.</u> of <u>Edwards</u>	<u>very light & shaly shale</u>		<u>130</u>
(distance) (direction) (Nearest Town)	<u>soft clay & lime</u>		<u>144</u>
(3) Topography: <input checked="" type="checkbox"/> (Hilly) <input checked="" type="checkbox"/> (Flat) <input type="checkbox"/> (Level)	<u>shale</u>		<u>242</u>
(4) Purpose of Well: <u>Michlens</u>	<u>Rock</u>		<u>245</u>
(Domestic Irrigation, Municipal, Industrial, Other)	<u>lime, shell & shale</u>		<u>226</u>
	<u>1/2 gal. shale & sand</u>		<u>905</u>
	<u>shale</u>		<u>930</u>
	<u>1/2 gal. shale, silt & sand</u>		<u>1047</u>
	<u>sand</u>		<u>1062</u>

Information upon completion of well:

- (1) Diameter 4x2 inches.
- (2) Total Depth 1062 feet.
- (3) Water Level 93 feet below top of ground.
- (4) Cased to 1062 feet, Size 2 3/4" - 4", Size 3 1/2" - 2".
- (5) Screen: Size 2", Length 20ft.
- (6) Were any formations sealed against pollution?
 yes, no.

CODED

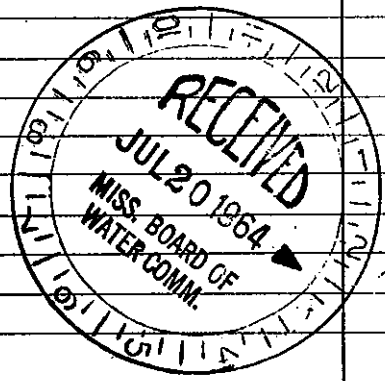

(Use Back Side)

Well No.

Mail this copy to Board of Water Commissioners 429 Miss. St. Jackson, Miss.