

Hinds
 J45
 8-19-74
 E Log # 544

MISSISSIPPI
 BOARD OF WATER COMMISSIONERS,
 416 North State Street
 Jackson, Mississippi 39201


CODED

WATER WELL DRILLERS LOG

8-19-74 date well completed JACK GUINN firm name Hinds county well located

LANDOWNER:	description of formations encountered	from	to
BISHOP, DL			
(mailing address)	CLAY	1	189
WELL LOCATION:	ROCK	189	230
sec. — T — N R — E	CLAY	230	390
1 S W	SAND	390	410
(distance) (direction) (nearest town)			
WELL PURPOSE: (home, irrigation, municipal, industrial)			
WELL COMPLETION DATA:			
(1) diameter (inches) 4x2"			
(2) total depth (feet) 425			
(3) static water level (feet) 170 below top of ground.			
(4) casing T&C 395' (material) (depth)			
4x2 (size) if telescope see back.			
(5) screen 10' 395' (length) (depth to top)			
2" 55 (size) (material)			
(6) pump 1 10 (HP) (yield gpm)			
MPL (type power)			
(7) electric log YES (yes or no)			
HARK USGS (organization running log)			
(8) how well bottom plugged B W V			
DRILLERS REMARKS: log RAW NEVER RECEIVED			

CODED

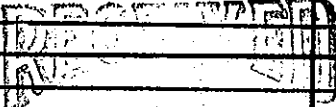

DEC 19 1974