

State Well Report

Part I

Mississippi Department of Environmental Quality
Office of Land and Water Resources
P.O. Box 10631
Jackson, MS 39289-0631
(601)961-5210
(601)354-6938 (fax)

For Office Use Only:

Aquifer: _____
Well #: J-85
L. S. Elevation: _____
E-log #: _____

49

County: Hinds
Permit #: 4" well
Driller: Waterwell Service
Date drilling completed: 11-21-04

State Law requires that this report be prepared by the driller in detail and filed with the Department within 30 days of completion of drilling of the well.

Well Owner Information	Well Location
Owner Name: <u>Dow M^cBroom</u>	Latitude: <u>32° 16' 43" N</u> Longitude: <u>90° 39' 43" W</u>
Mailing Address: <u>4630 Smith Sta Rd</u> <u>Edwards, MS</u> <u>Edwards, MS 39066</u>	Method of Lat/Long (circle one): <input type="checkbox"/> Conventional Survey, <input type="checkbox"/> USGS quad, <input type="checkbox"/> Hand-held GPS, <input type="checkbox"/> Survey-grade GPS
City: _____ State: _____ Zip Code: _____	<u>SW</u> ¼ <u>NE</u> ¼ Sec <u>13</u> Twn <u>15N</u> Rng <u>3W</u> <u>5E</u>
Telephone No: <u>601-661-7090</u>	Distance: <u>1.5</u> Miles Direction: <u>W/S</u> of Nearest Town: <u>Edwards</u>

Well Data

Purpose of Well (circle one) Home Industrial Public Supply Irrigation Fish Culture Other: _____

Date well drilling started: 11-15-04 Date well drilling completed: 11-17-04

If flowing, method of flow regulation: Valve _____ Other (describe) _____

Static Water Level: 36 feet above or below (circle one) land surface Date measured: 11-17-04

Method of Measurement (circle one) steel tape electric tape air line other: _____

Hole depth: 180 Well depth: 125 Well grouted to a depth of 20 feet

Type of grout (circle one): Cement Bentonite Mix

Casing length: 105 feet Casing diameter: 4 inches Type of casing: PVC

Screen length: 20 feet Screen diameter: 4 inches Type of screen: PVC

Screen slot size: 0.08 inches Setting depth: From 105 feet to 125 feet

Type of completion (circle all applicable): Gravel packed Underreamed Telescoped Open hole Natural Development
Other (describe): _____

Top of lap pipe or reduction in casing: _____ feet. If telescoped or more than one screen, describe on back of page

Logs run (circle all applicable): No log run Electric Gamma Ray Density Sonic Neutron Other: _____

Name of organization running log(s): State Logger Log # 5-0085

I certify that the well was drilled, constructed, and completed in accordance with all applicable requirements of the Mississippi Department of Environmental Quality and/or the Mississippi Department of Health regulations and state laws.

Arnold Fincher Sr 0598

Arnold Fincher Sr

Print Name of Water Well Contractor and License No.

Signature of Water Well Contractor

RECEIVED
DEC 15 2004
BY: OLWR

If well telescopes please sketch below and show depths.


Ground Level

5-25

Description of Formations Encountered	From	To
Sandy clay	0	55
Sand	55	65
Limestone	65	100
Sand	100	125
Clay	125	150
Sand	150	170
clay	170	18

If more than one screen, show location of each on sketch

Sketch the property layout and include the following: 1) the well location; 2) any permanent structures on the property that may aid in locating the well; 3) any roads, power lines, or other items that may aid in locating the property and the well; 4) indicate direction.

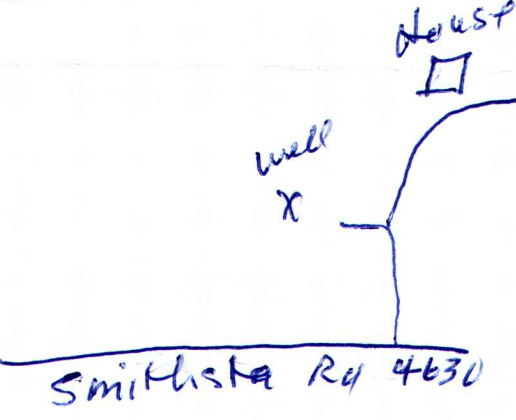

Landowner Name: _____

David Sanchez Sr
Signature of Water Well Contractor

RECEIVED
DEC 15 2004
BY: OLWR

STATE WELL REPORT

Part 2

Pump Installer's Completion Report
 Mississippi Department of Environmental Quality
 Office of Land and Water Resources
 P.O. Box 10631
 Jackson, MS 39289-0631
 (601)961-5210
 (601)354-6938 (fax)

For Office Use Only:

Aquifer: _____
 Well #: 2-85
 Elevation: _____

County: Hinds
 Permit #: 411 well
 Driller: Water Well Service
 Date completed: 11-20-04

This report should be prepared by the pump installer in detail and filed with the Department within 30 days of the installation of pump.

Well Owner Information	Well Location
Owner Name: <u>Don Mc Broom</u>	Latitude: <u>321643 N</u> Longitude: <u>903943 W</u>
Mailing Address: <u>4630 Smiths Rd</u>	Method of Lat/Long (circle one): Conventional Survey,
<u>Edwards, Ms 39066</u>	USGS quad, <u>Hand-held GPS</u> , Survey-grade GPS
City State Zip Code	_____ 1/4 _____ 1/4 Sec <u>13</u> Twn <u>15</u> Rng <u>30</u>
Telephone No. <u>(601) 661-7090</u>	Distance Direction Nearest Town
	<u>15</u> Miles <u>W/S</u> of <u>Edwards</u>

Pump Type Circle one	Power Type Circle one
Air Lift Jet <input type="radio"/> <u>Submersible</u>	Diesel Engine Gasoline Engine Natural Gas
Bucket Piston <input type="radio"/> Turbine <input type="radio"/>	<u>Electric Motor</u> Hand <input type="radio"/> Tractor PTO <input type="radio"/>
Centrifugal Rotary <input type="radio"/> Flowing Well <input type="radio"/>	Windmill Other (specify): _____
Other (specify): _____	Horse Power Rating of Motor: <u>1.0</u>
Date Pump Installed: <u>11-20-04</u>	Setting Depth: <u>110</u> feet
Rated Pump Capacity: <u>12</u> Gallons Per Minute	Number of Stages: <u>9</u>

Pump Test Data	Method of Measuring Water Level Circle one
Date Well Tested: <u>11-20-04</u>	Air Line <input type="radio"/> <u>Electric Measuring Line</u> <input type="radio"/> Steel Tape
Static Water Level (A): <u>36</u> Feet Below Land Surface	Other (specify): _____
Pumping Water Level (B): <u>81</u> Feet Below Land Surface	For flowing well, measured shut in head: _____ feet
Drawdown [(B) - (A)]: <u>45</u> Feet Below Land Surface	Well yielded _____ GPM with a drawdown of _____ feet after _____ hours of pumping
Test Pumping Rate: <u>15</u> Gallons Per Minute	
Duration of Pump Test (minimum 4 hours): <u>5</u> hours	

I HEREBY CERTIFY that the above statements are true to the best of my knowledge.

Arnold Fincher Sr 0598 Arnold Fincher Sr
 Print Name of Pump Installer and License No. (if applicable) Signature of Pump Installer

RECEIVED
 DEC 15 2004
 BY: OLWR