

HINDS MISSISSIPPI BOARD OF WATER COMMISSIONERS

J 2000
7-11-60

WATER WELL DRILLERS LOG

?
Hard or Warm

Date: 7-11, 1960, Driller: Setch County Clay
(Name)

(1) Owner of Land:	Description & Color of Materials Sand, Clay, Red Clay, Shell, etc.	Thick- ness Feet	Depth Feet
(Name) <u>R. E. Mundy</u>			
(Address) <u>Utica Miss</u>	<u>0-30 clay</u>		
(2) Location: $\frac{1}{4}$ Sec. <u>TR 46</u>	<u>30-41 sand</u>		
<u>North</u>	<u>41-43 clay</u>		
<u>12</u> miles <u>North</u> of <u>Utica</u>	<u>43-62 sand</u>		
(distance) (direction) (Nearest Town)			
(3) Topography: <u>Hilly</u>			
(Hilly) (Flat) (Level)			
(4) Purpose of Well: <u>Home use</u>			
(Domestic Irrigation Municipal, Industrial, Other)			


Information upon completion of well:

- (1) Diameter 7 inches.
- (2) Total Depth 62 feet.
- (3) Water Level 40 feet below top of ground.
- (4) Cased to 57, Size 2"
- (5) Screen: Size 2", Length 6'
- (6) Were any formations sealed against pollution?
_____ yes, no no.

If YES depth of formation _____

Why _____

Drillers Remarks: _____

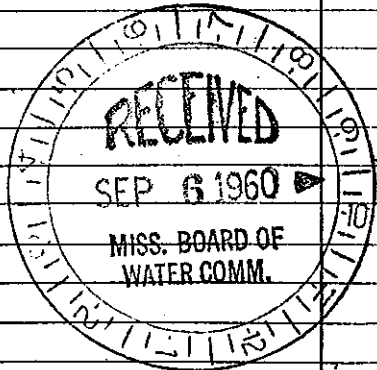

(Use Back Side)

Well No.

Retain this copy for your office files.