

HINDS

MISSISSIPPI BOARD OF WATER COMMISSIONERS

J 2002
10-26-62

WATER WELL DRILLERS LOG


Forest Drilling

Date 10/24 to 10/26 1962, Driller: Johnnie Beasley County Hinds
(Name)

	Description & Color of Materials Sand, Clay, Red Clay, Shell, etc.	Thick- ness Feet	Depth Feet
(1) Owner of Land: <u>Austin Moore</u> (Name) <u>Edwards, Miss.</u> (Address)	Brown silt.	35	35
(2) Location: <u>1/4</u> , <u>1/4</u> , Sec. <u>T.5N R.4W</u> <u>10 miles South</u> , of <u>Edwards</u> (distance) (direction) (Nearest Town)	Chalky clay.	25	60
(3) Topography: <u>x</u> (Hilly) (Flat) (Level)	Fine sand & gravel	5	65
(4) Purpose of Well: <u>Domestic Home</u> (Domestic Irrigation Municipal, Industrial, Other)	Rock.	35	100
Information upon completion of well:	Sand & clay.	30	130
(1) Diameter <u>2</u> inches.	Shale.	16	146
(2) Total Depth <u>310</u> feet.	Sand & stks. shale.	17	163
(3) Water Level <u>30'</u> feet below top of ground.	Shale & stks. sand.	21	184
(4) Cased to <u>295'</u> , Size <u>2"</u> .	Hard shale.	41	225
(5) Screen: Size <u>2"</u> , Length <u>15'</u> .	Shale & stks. silt.	28	253
(6) Were any formations sealed against pollution? <u>no.</u>	Fine sand.	5	258
If YES depth of formation _____	Shell.	3	261
Why _____	Fine sand.	5	266
Drillers Remarks: <u>Good well.</u>	Shale & stks. silt.	4	270
	Fine sand.	16	286
	Sand. (Screen setting.)	24	310

FOREST DRILLING SERVICE

P. O. Box 5717
PEARL BRANCH
JACKSON 8, MISS.

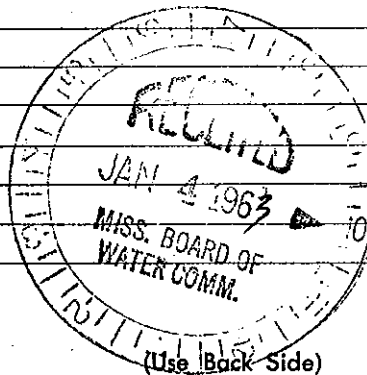

Well No.

Mail this copy to Board of Water Commissioners 429 Miss. St. Jackson, Miss