

HINDS MISSISSIPPI BOARD OF WATER COMMISSIONERS


J 2004  
7-63

WATER WELL DRILLERS LOG

(R.G.)

Date: July, 1963, Driller: MCNEECE DRILLING County HINDS  
(Name CA)

|  |  | Description & Color of Materials<br>Sand, Clay, Red Clay, Shell, etc. | Thick-<br>ness<br>Feet | Depth<br>Feet |
|--|--|---|------------------------|---------------|
| (1) Owner of Land: <u>GEORGE GERVIN</u><br>(Name)  |  | <u>SURFACE SOIL</u>   | <u>15</u>              | <u>15</u>     |
| <u>EDWARDS MISS</u><br>(Address)   |  | <u>WHITE SHALE</u>  | <u>25</u>              | <u>40</u>     |
| (2) Location: <u>SW</u> $\frac{1}{4}$ , <u>5N</u> , $\frac{1}{4}$ , Sec. <u>12</u> T. <u>56N</u> R. <u>56W</u> |  | <u>WHITE SAND</u>   | <u>16</u>              | <u>56</u>     |
| <u>6</u> miles <u>SW</u> of <u>EDWARDS</u><br>(distance) (direction) (Nearest Town)                            |  | <u>SHALE</u>  | <u>4</u>               | <u>60</u>     |
| (3) Topography: <u>LEVEL</u><br>(Hilly) (Flat) (Level)   |  | <u>SAND</u>   | <u>17</u>              | <u>77</u>     |
| (4) Purpose of Well: <u>DOMESTIC Home</u><br>(Domestic Irrigation, Municipal, Industrial, Other)               |  | <u>ROCK LEDGES</u>  | <u>56</u>              | <u>133</u>    |
| Information upon completion of well:   |  | <u>SHALE</u>  | <u>21</u>              | <u>154</u>    |
| (1) Diameter <u>4 X 2</u> inches.  |  | <u>SHALE, SAND &amp; LIGNITE</u>                                      | <u>43</u>              | <u>197</u>    |
| (2) Total Depth <u>916</u> feet.   |  | <u>SHALE</u>  | <u>566</u>             | <u>763</u>    |
| (3) Water Level <u>50</u> feet below top of ground.  |  | <u>SHALE, SHELL &amp; SAND</u>  | <u>19</u>              | <u>782</u>    |
| (4) Cased to <u>311 ft</u> , Size <u>4"</u>  |  | <u>SAND</u>   | <u>26</u>              | <u>808</u>    |
| (5) Screen: Size <u>2"</u> , Length <u>20</u>  |  | <u>SHALE</u>  | <u>10</u>              | <u>818</u>    |
| (6) Were any formations sealed against pollution?<br>____ yes, <u>X</u> no.                                    |  | <u>SHALE &amp; SAND</u>   | <u>57</u>              | <u>875</u>    |
| If YES, depth of formation _____   |  | <u>SAND</u>   | <u>41</u>              | <u>916</u>    |
| Why _____  |  |   |                        |               |
| Drillers Remarks: _____  |  |   |                        |               |
|  |  |   |                        |               |
|  |  |   |                        |               |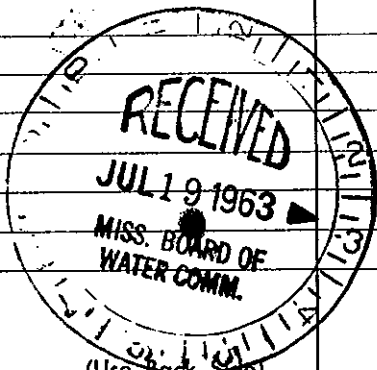
Well No. 56

Mail this copy to Board of Water Commissioners 429 Miss. St. Jackson, Miss