

HINDS

J


MISSISSIPPI BOARD OF WATER COMMISSIONERS

2005  
5-19-64

WATER WELL DRILLERS LOG

Date: 5-19-64, Driller: James McNEES County: HINDS  
(Name)

(1) Owner of Land	Description & Color of Materials Sand, Clay, Red Clay, Shell, etc.	Thick- ness Feet	Depth Feet
Mrs L.F. ANGLO (Name)	CLAY	30	30
Edwards MISS (Address)	SAND	13	43
(2) Location: 1/4, 1/4, Sec. T5R4E	SAND - GRVEL	5	48
1 1/2 miles south of Edwards (distance) (direction) (Nearest Town)	ROCK - SH STKS	37	85
(3) Topography: <input checked="" type="checkbox"/> (Hilly) <input type="checkbox"/> (Flat) <input type="checkbox"/> (Level)	Grey sdy sh	3	88
(4) Purpose of Well: Domestic Home (Domestic Irrigation, Municipal, Industrial, Other)	SAND	4	92
Information upon completion of well:	Grey sdy sh	8	100
(1) Diameter 2 inches.	SAND	6	106
(2) Total Depth 140 feet.	Grey sdy sh	4	110
(3) Water Level 38 feet below top of ground.	SAND	5	115
(4) Cased to 105', Size 2"	SAND sh STKS	5	120
(5) Screen: Size NONE, Length	Grey shale	20	140
(6) Were any formations sealed against pollution?			
yes, <input checked="" type="checkbox"/> no.			
If YES depth of formation			
Why			
Drillers Remarks:			

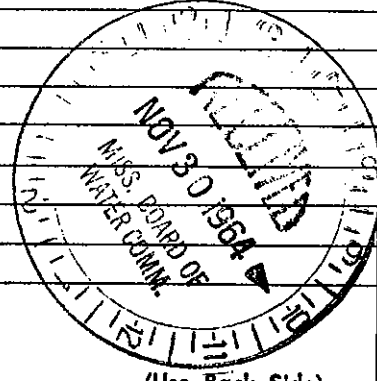

(Use Back Side)

Well No.

Mail this copy to Board of Water Commissioners 429 Miss. St. Jackson, Miss