

HINDS MISSISSIPPI BOARD OF WATER COMMISSIONERS

J 2006
11-12-64

WATER WELL DRILLERS LOG

Date: NOV 12, 1964, Driller: Elmer C. Hall County HINDS
HALL DRILLING CO

(1) Owner of Land: L. B. SWEENEY JR
(Name)
RT 1 EDWARDS MISS
(Address)

(2) Location: N.E. 1/4, 1/4, Sec. 1 T. 14 N R. 4 W
9 miles N.W. of RAYMOND
(distance) (direction) (Nearest Town)

(3) Topography: FLAT
(Hilly) (Flat) (Level)

(4) Purpose of Well: DOMESTIC HOME
(Domestic Irrigation) (Municipal, Industrial, Other)

Description & Color of Materials Sand, Clay, Red Clay, Shell, etc.	Thick- ness Feet	Depth Feet
SURFACE SOIL	4	4
RED CLAY	14	18
WHITE SAND	10	28
SHALE	10	38
ROCK SAND + SHALE	25	63
ROCK SAND + GRAVEL	20	83
SHALE	43	126
ROCK LEDGES	60	186
SAND + SEA SHELL	10	196
SHALE (HARD)	17	213
SAND-SHALE-LIENITE	38	251
SAND MED	10	261
SHALE	13	274

Information upon completion of well:

(1) Diameter 4 X 2 inches.

(2) Total Depth 274 feet. 261

(3) Water Level 6 feet below top of ground.

(4) Cased to 191 ²⁵¹, Size 4"
160 2


(5) Screen: Size 2, Length 10'

(6) Were any formations sealed against pollution?
no, X yes.

If YES depth of formation _____

Why _____

Drillers Remarks: _____

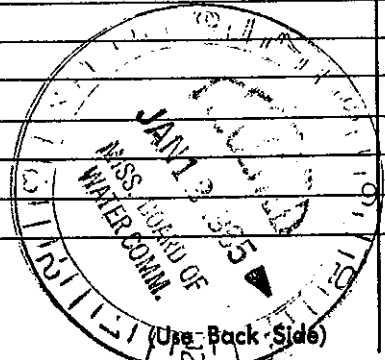

Well No.
4

Mail this copy to Board of Water Commissioners 429 Miss. St. Jackson, Miss