

HINDS MISSISSIPPI BOARD OF WATER COMMISSIONERS


J 2007

3-21-66

WATER WELL DRILLERS LOG

Date: 3/21, 1966, Driller: Paul Dilling County: Hinds
(Name)

(1) Owner of Land:	Description & Color of Materials Sand, Clay, Red Clay, Shell, etc.	Thick- ness Feet	Depth Feet
<u>Alma Hog Farm</u> (Name)	<u>Brown Silt + Clay</u>		<u>20</u>
<u>Edwards Miss</u> (Address)	<u>Gravel</u>		<u>30</u>
(2) Location: <u>SW 1/4, NW 1/4, Sec. 16</u>	<u>Chalky Clay</u>		<u>55</u>
<u>4</u> miles <u>South</u> of <u>Edwards</u>	<u>Blue Clay + Shell</u>		<u>105</u>
(3) Topography: <u>Level</u>	<u>Rock</u>		<u>112</u>
(4) Purpose of Well: <u>Hog Farm</u>	<u>Rock + sths lime</u>		<u>142</u>
	<u>lime, shell + shale</u>		<u>215</u>
	<u>Hard shale</u>		<u>309</u>
	<u>Shale + sths silt</u>		<u>327</u>
	<u>Fine sand + sths shell</u>		<u>348</u>
	<u>Shale + sths sand</u>		<u>363</u>
	<u>Shale (hard blue)</u>		<u>833</u>
	<u>Soft shale + lignite</u>		<u>841</u>
	<u>Soft shale</u>		<u>882</u>
	<u>Shale</u>		<u>915</u>
	<u>Shale + sths rock</u>		<u>932</u>
	<u>Shale</u>		<u>1010</u>
	<u>Shale + sths silt</u>		<u>1040</u>
	<u>Fine sand</u>		<u>1052</u>
	<u>Shale</u>		<u>1064</u>
	<u>Shale + sths silt sand</u>		<u>1094</u>
	<u>Rock</u>		<u>1096</u>
	<u>Shale + sths silt</u>		<u>1115</u>
	<u>Silt + sths shale</u>		<u>1136</u>
	<u>Fine sand + sths shale</u>		<u>1157</u>
	<u>Fine sand + shale</u>		<u>1178</u>
	<u>Shale</u>		<u>1188</u>
	<u>Fine sand</u>		<u>1198</u>
	<u>Shale</u>		<u>1210</u>
	<u>Fine sand (underway)</u>		<u>1280</u>

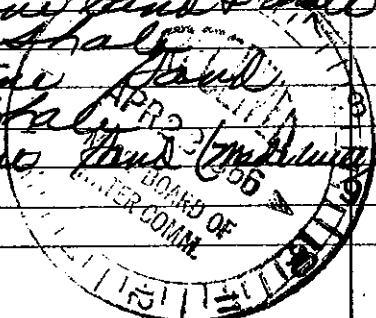

(Use Back Side)

Well No.

Mail this copy to Board of Water Commissioners 429 Miss. St. Jackson, Miss.