

Hinds
 J 2008
 9-67

MISSISSIPPI
 BOARD OF WATER COMMISSIONERS
 416 North State Street
 Jackson, Mississippi 39201

WATER WELL DRILLERS LOG

9/14/67 19 Best Drilling Hinds
 date well completed firm name county well located

LANDOWNER: J.E. Sullender
Robt Roy Plantation
Edwards
Miss.
 (mailing address)


description of formations encountered	from	to
Brown Clay	0	20
Gravel + red sand		40
Clay		61
Hard Clay		122
Rock		164
Red + Shale Clay		184
Hard Shale		204
Shale		225
Fine Sand + Clay		235
Clay		245
Shale		492
Soft Shale		512
Hard Shale		554
Shale		657
Shale + Shale Sand		677
Shale		799
Shale + Shale Sand		819
Shale		859
Soft Shale + Silt		899
Silt + Sand		913
Fine Sand		933

WELL LOCATION:
 sec 12 T 15 N R 3 E SE
3 miles South of Smith
 (distance) (direction) (nearest town)

WELL PURPOSE: Home
 (home, irrigation, municipal, industrial)

WELL COMPLETION DATA:

- (1) diameter (inches) 2"
- (2) total depth (feet) 930
- (3) static water level (feet) 94 below above top of ground.
- (4) casing Galv. 915
 (material) (depth)
2" if telescope see back
 (size)
- (5) screen 15ft 915
 (length) (depth to top)
2" Chrome
 (size) (material)
- (6) pump 3 air 1300 gpm
 (HP) (yield gpm) 70
Elect
 (type power)
- (7) electric log No
 (yes or no)
 (organization running log)
- (8) how well bottom plugged Backwash
blue

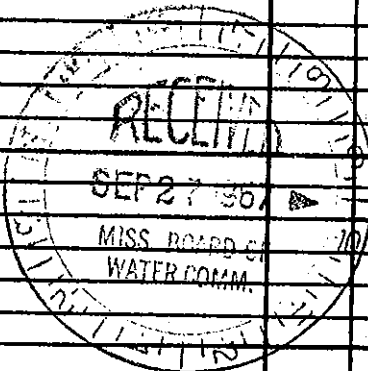

DRILLERS REMARKS: