

HINDS

K

WATER WELL DRILLERS LOG

L300

8-25-60

Date: AUG 25, 1960, Driller: MENECE DRINKING Co County HINDS

(Name)

- (1) Owner of Land: GEO. DAVIS JR.
(Name)
RT. 2, RAYMOND MISS
(Address)
- (2) Location: W 1/4, SE 1/4, Sec. 15 T5 R N
2 WEST
2 miles N, of RAYMOND
(distance) (direction) (Nearest Town)
- (3) Topography: HILLY
(Hilly) (Flat) (Level)
- (4) Purpose of Well: DOMESTIC
(Domestic Irrigation
Municipal, Industrial, Other)

Description & Color of Materials Sand, Clay, Red Clay, Shell, etc.	Thick- ness Feet	Depth Feet
RED CLAY SOIL	8	0
SAND ROCK	6	8
WHITE SHALE	16	14
SAND ROCK	2	30
GREY SHALE	13	32
GREY SHALE	70	45
ROCK LEDGES	18	115
GREY SHALE	97	133
ROCK LEDGES	10	230
FINE SAND + SHALE	160	240
FINE SAND	65	300
WATER SAND		365
		403


Information upon completion of well:

- (1) Diameter 3 inches.
- (2) Total Depth 403 feet.
- (3) Water Level 94 feet below top of ground.
- (4) Cased to 217', Size 3"
217' - 383' - 2"
- (5) Screen: Size 2", Length 20'
- (6) Were any formations sealed against pollution?
no.

If YES depth of formation _____

Why _____

Drillers Remarks: _____

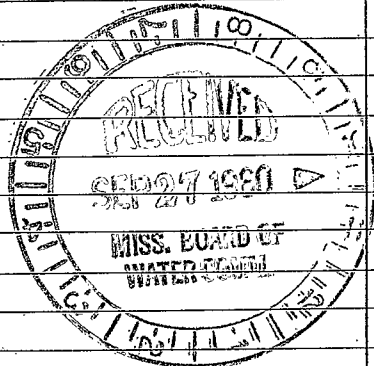

(Use Back Side)

Well No. 4