

HINDS

MISSISSIPPI BOARD OF WATER COMMISSIONERS

K 12

7-16-65

WATER WELL DRILLERS LOG

CODED

Date: 7-16-65, Driller: James McNEES County Hinds

(1) Owner of Land: A. D. Ranch  
 (Name)  
Raymond Miss  
 (Address)

(2) Location: NW 1/4, SW 1/4, Sec 29 T 5 R 5  
3 miles south of Raymond  
 (distance) (direction) (Nearest Town)

(3) Topography:  (Hilly)  (Flat)  (Level)

(4) Purpose of Well: Domestic  
 (Domestic Irrigation, Municipal, Industrial, Other)

Description & Color of Materials Sand, Clay, Red Clay, Shell, etc.	Thick- ness Feet	Depth Feet
surface soil	15	15
sand	20	35
Blue shale	65	100
sand	3	103
Blue shale	17	120
sand	4	124
Blue shale	19	143
Grey shale	40	183
Rock sh strks	67	250
Grey sdy sh	22	272
sand	3	275
Grey shale CODED	64	339
Grey sdy sh	18	357
sand	2	359
Grey sdy sh	1	360
Grey shale	409	769
sand sh strks	63	832
Grey shale	56	888
sand	4	892
sand sh strks	38	930
sand	11	1041
17 lbs 4"	358	5
1 4x2 swager	1	
	359	5
30 lbs 2"	631	4
	990	9
3-10' 1" 1/2	30	
	1020	9
1-11' 1" 1/2	910	3
	1021	0

Information upon completion of well:

(1) Diameter 4" x 2" inches.

(2) Total Depth 1041 feet.

(3) Water Level 204 feet below top of ground.

(4) Cased to 990, Size 4" x 2"


(5) Screen: Size 2" 008, Length 20

(6) Were any formations sealed against pollution?  
 yes,  no.

If YES depth of formation \_\_\_\_\_

Why \_\_\_\_\_

Drillers Remarks: \_\_\_\_\_

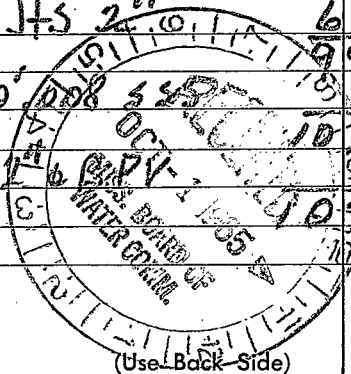

Well No.

