

MISSISSIPPI  
BOARD OF WATER COMMISSIONERS  
416 North State Street  
Jackson, Mississippi 39201

**CODED**

WATER WELL DRILLERS LOG

Hinds  
K 14  
8-68  
Miss Des Survey  
8-30 1968

James D McNEPS Hinds  
date well completed firm name county well located

LANDOWNER: P.O. BRYANT  
Raymond MISS  
(mailing address)

description of formations encountered	from	to
Surface soil clay	0	20
Blue shale	20	135
ROCK 3h strks	135	186
Shale - 2nd	186	190
Sandy sh	190	198
SAND	198	202
SAND - shale	202	206
Grey shale	206	239
SAND - Lignite	239	243
Grey sdy sh	243	246
Grey shale	246	328


WELL LOCATION:  
sec 29 T 5 N R 3 E  
6 1/2 miles S.W. of Raymond  
(distance) (direction) (nearest town)

WELL PURPOSE: HOME  
(home, irrigation, municipal, industrial)

WELL COMPLETION DATA:  
(1) diameter (inches) 4" x 2"  
(2) total depth (feet) 328  
(3) static water level (feet) 95 below top of ground.  
(4) casing steel 180  
(material) (depth)  
If telescope see back. 180  
(size)  
(5) screen 17 180  
(length) (depth to top)  
2", 007 stainless  
(size) (material) steel  
(6) pump 3/4 8  
(HP) (yield gpm)  
Elec.  
(type power)  
(7) electric log yes  
(yes or no)  
M.G.S  
(organization running log)  
(8) how well bottom plugged mod

8 fts 4" 179  
1-4x 3 Swadge 1  
3' 2" JOHNSON 180  
007 stainless  
steel screens 17  
197


**CODED**

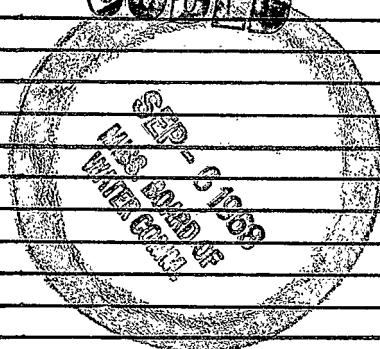

DRILLERS REMARKS:  
Water has  
No color

If well telescopes please sketch and show depths.

GROUND LEVEL

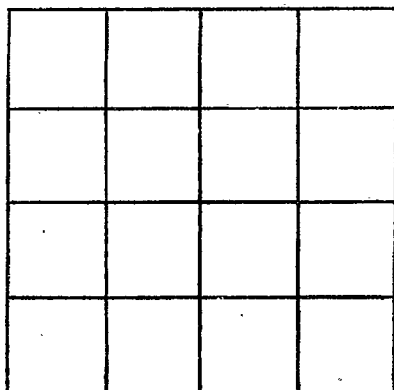

SECTION \_\_\_\_\_

Please indicate well location X.

ADDITIONAL INFORMATION

If more than one screen, show locations of each on sketch.