

MISSISSIPPI
BOARD OF WATER COMMISSIONERS
416 North State Street
Jackson, Mississippi 39201

CODED

WATER WELL DRILLERS LOG

1/9 1969 Forest Drilling Hinds
date well completed firm name county well located

LANDOWNER: Conant, H. B.
Box 195
Raymond, Miss.
(mailing address)

WELL LOCATION:
sec. 22 T. 5 N. R. 3 E
4 miles E of Raymond
(distance) (direction) (nearest town)

WELL PURPOSE: home
(home, irrigation, municipal, industrial)

WELL COMPLETION DATA:

- (1) diameter (inches) 4" x 2"
- (2) total depth (feet) 1115'
- (3) static water level (feet) 142' below top of ground.
- (4) casing Galv. 1100'
(material) (depth)
- 4-2" If telescope see back.
(size)
- (5) screen 15' 1100'
(length) (depth to top)
2" stainless steel
(size) (material)
- (6) pump 1 Sub 10
(HP) (yield gpm)
Elect
(type power)
- (7) electric log no
(yes or no)

(organization running log)

(8) how well bottom plugged 2" Backwash
Uave

DRILLERS REMARKS:

description of formations encountered	from	to
<u>Brown clay</u>	<u>0</u>	<u>40</u>
<u>Clay</u>	<u>40</u>	<u>97</u>
<u>Limestone</u>	<u>97</u>	<u>102</u>
<u>Rock + str. clay</u>	<u>102</u>	<u>145</u>
<u>shale + str. sand</u>	<u>145</u>	<u>225</u>
<u>shale</u>	<u>225</u>	<u>774</u>
<u>shale + str. rock</u>	<u>774</u>	<u>814</u>
<u>shale + mucky sand</u>	<u>814</u>	<u>875</u>
<u>fine sand + shale</u>	<u>875</u>	<u>937</u>
<u>dot shale, fine sand</u>	<u>937</u>	<u>1061</u>
<u>dot shale + mucky sand</u>	<u>1061</u>	<u>1082</u>
<u>fine sand</u>	<u>1082</u>	<u>1115</u>
<u>Clay + str. sand</u>	<u>1115</u>	<u>1125</u>


CODED

JAN 10 1969

MISS. BD. OF
WATER CONTROL

If well telescopes please sketch and show depths.

GROUND LEVEL

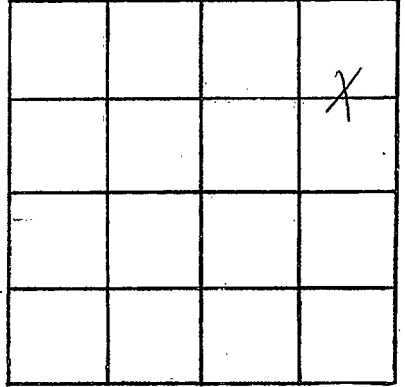

SECTION 22

Please indicate well location X.

ADDITIONAL INFORMATION

If more than one screen, show locations of each on sketch.