

HINDS

K 24

11-24-70

MISSISSIPPI
 BOARD OF WATER COMMISSIONERS
 416 North State Street
 Jackson, Mississippi 39201

ELOG # 395

CODED

WATER WELL DRILLERS LOG

11-24-1970

James D McNEES

HINDS

date well completed

firm name

county well located

LANDOWNER: Terry Worrell

REYMOND MISS

(mailing address)

WELL LOCATION:

sec. 1 T. 5 N R. 3 E
 5 miles west of Bolton
 (distance) (direction) (nearest town)

WELL PURPOSE: HOME
 (home, irrigation, municipal, industrial)

WELL COMPLETION DATA:

- (1) diameter (inches) 4" x 2"
- (2) total depth (feet) 208
- (3) static water level (feet) 84 below top of ground
- (4) casing: steel (material), 190' (depth)

- (5) screen: 15' (length), 190' (depth to top), 2" stainless steel (size, material)

- (6) pump: 3/4 (HP), 10 (yield gpm)

Elec (type power)

- (7) electric log: yes (yes or no), MGS (organization running log)

- (8) how well bottom plugged: BACK Wash Valve

description of formations encountered

from

to

SURFACE SOIL	0	10
CLAY	10	30
GREY SHALE	30	70
✓ SDY SHALE	70	90
SAND	90	98
GREY SHALE	98	123
LIME ROCK	125	177
SAND	177	181
SAND & SHALE	181	194
SAND	194	203
SAND & SHALE	203	208

9 fts 4"	181	
1 4" x 2" SWEDGE	1	
1 1/2" "	182	
1 ft. 2" pipe	8	
	190	
2" JOHNSTON 007		
STAINLESS STEEL		
SCREEN	15	
	205	

CODED

FEB 4 1971


DRILLER'S REMARKS:

Water Does Not have color

MISS. BD. OF WATER COMMISSIONERS

If well telescopes please sketch and show depths.

GROUND LEVEL

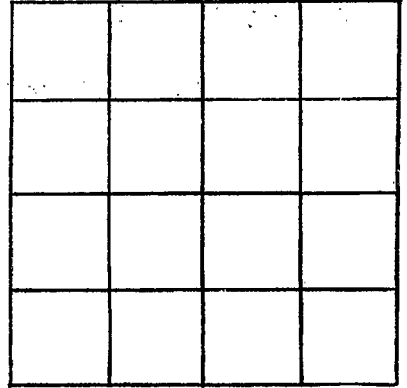

SECTION _____

Please indicate well location X.

ADDITIONAL INFORMATION

If more than one screen, show locations of each on sketch.