

HINDS Co
K34
1 #441
Aug 1974
3 74

MISSISSIPPI
BOARD OF WATER COMMISSIONERS
416 North State Street
Jackson, Mississippi 39201

CODED

WATER WELL DRILLERS LOG

19 72 JACKSON HINDS
date well completed firm name county well located

LANDOWNER:
LESLIE COLEMAN

(mailing address)

description of formations encountered	from	to
TOP SOIL	0	2
CLAY	2	102
ROCK	102	147
CLAY	147	150
SAND	150	160

WELL LOCATION:
sec. 19 T. 5 N R. 3 E
3 miles W of Edwards
(distance) (direction) (nearest town)

WELL PURPOSE:
(home, irrigation, municipal, industrial)

- WELL COMPLETION DATA:
- (1) diameter (inches) 4 1/2
 - (2) total depth (feet) 160
 - (3) static water level (feet) 20 below above top of ground.
 - (4) casing Idc 157
(material) (depth)
4 1/2 If telescope see back
(size)
 - (5) screen 15 157
(length) (depth to top)
2" SS
(size) (material)
 - (6) pump 1 10
(HP) (yield gpm)
CEPT
(type power)
 - (7) electric log yes
(yes or no)
MGS
(organization running log)
 - (8) how well bottom plugged BWU


CODED

DRILLERS REMARKS:

APR 25 1974

If well telescopes please sketch and show depths.

GROUND LEVEL

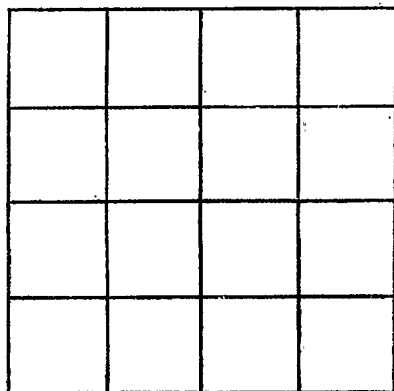

SECTION _____

Please indicate well location X.

ADDITIONAL INFORMATION

If more than one screen, show locations of each on sketch.