

H. E. VANDERBERG LE

MISSISSIPPI
BOARD OF WATER COMMISSIONERS
416 North State Street
Jackson, Mississippi 39201

WATER WELL DRILLERS LOG

HINDS Co.
K35

Log # 444
531

19 72 JACKSON Hinds
date well completed firm name county well located

CODED

LANDOWNER: W. W. NOLAN
well owner
WANDERBERG LE
(mailing address)

description of formations encountered	from	to
TOP SOIL	0	2
CLAY	2	113
ROCK	113	154
SAND	154	168

WELL LOCATION:
sec. 30 T. 5 N. R. 3E
5 miles S of Edward
(distance) (direction) (nearest town)

CODED

WELL PURPOSE:
(home, irrigation, municipal, industrial)


- WELL COMPLETION DATA:
- (1) diameter (inches) 4"
 - (2) total depth (feet) 168
 - (3) static water level (feet) 42' ^{below} ~~above~~ top of ground.
 - (4) casing JAL 153'
(material) (depth)
44 if telescope see back.
(size)
 - (5) screen 151' 153'
(length) (depth to top)
24 SS
(size) (material)
 - (6) pump 1 10
(HP) (yield gpm)
CEPA
(type power)
 - (7) electric log YES
(yes or no)
MBS
(organization running log)
 - (8) how well bottom plugged BWU

DRILLERS REMARKS:

ADDS
MAY 1973

If well telescopes please sketch and show depths.

GROUND LEVEL

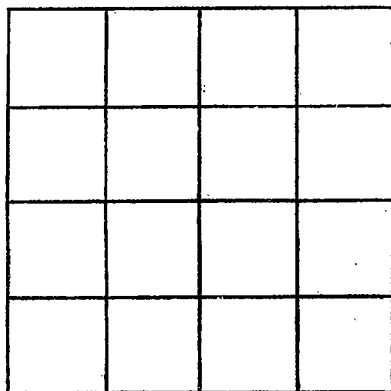

SECTION _____

Please indicate well location X.

ADDITIONAL INFORMATION

If more than one screen, show locations of each on sketch.