

HINDS
K41
524
7-21-73

MISSISSIPPI
BOARD OF WATER COMMISSIONERS
416 North State Street
Jackson, Mississippi 39201

CODED

WATER WELL DRILLERS LOG

7-21-1973 date well completed
13 JALB Gorman HINDS firm name
county well located

LANDOWNER:	Description of formations encountered	from	to
H. J. JELKS JELKS	TOP SOIL	0	2
	CLAY	2	109
	ROCK	109	160
	SAND	160	170
(mailing address)			
WELL LOCATION: sec. 19 T. 5 N R. 3 E 3 miles S of Edwards			
(distance) (direction) (nearest town)			
WELL PURPOSE: (home, irrigation, municipal, industrial)			
WELL COMPLETION DATA:			
(1) diameter (inches) 2 1/2			
(2) total depth (feet) 170			
(3) static water level (feet) 76 below top of ground.			
(4) casing 2" (material) 160 (depth)			
2" If telescope see back. (size)			
(5) screen 10 (length) 160 (depth to top)			
2 (size) SS (material)			
(6) pump 1 (HP) 3 (yield gpm)			
Reck (type power)			
(7) electric log Yes (yes or no)			
MBS (organization running log)			
(8) how well bottom plugged 1300			
DRILLERS REMARKS:			


CODED

SEP 5 1973

MISS. BOARD OF WATER COMMISSIONERS

If well telescopes please sketch and show depths.

GROUND LEVEL

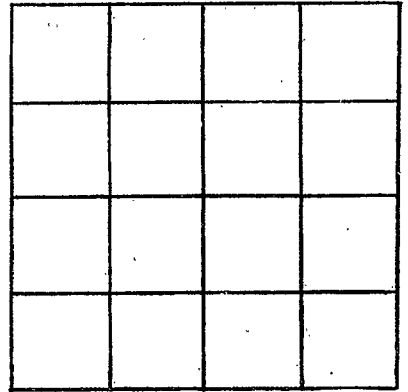

SECTION _____

Please indicate well location X.

ADDITIONAL INFORMATION

If more than one screen, show locations of each on sketch.