

HINDS
K 43
8/12/74
E. H. 595

MISSISSIPPI
BOARD OF WATER COMMISSIONERS
416 North State Street
Jackson, Mississippi 39201

CODED

WATER WELL DRILLERS LOG

8/12/74 19 K. E. Thompson Hinds
date well completed firm name county well located

LANDOWNER:	description of formations encountered	from	to
<u>J. K. Miller</u> <u>Raymond</u> (mailing address)			
WELL LOCATION: sec. <u>24</u> T. <u>5</u> N. R. <u>0</u> E. S. W.	<u>clay</u>	<u>5</u>	<u>60</u>
<u>3</u> miles <u>W</u> of <u>Raymond</u> (distance) (direction) (nearest town)	<u>Brass clay</u>	<u>60</u>	<u>100</u>
WELL PURPOSE: <u>home</u> (home, irrigation, municipal, industrial)	<u>limestone</u>	<u>100</u>	<u>140</u>
WELL COMPLETION DATA:	<u>limestone</u>	<u>140</u>	<u>180</u>
(1) diameter (inches) <u>2"</u>	<u>hard shale</u>	<u>180</u>	<u>200</u>
(2) total depth (feet) <u>365'</u>	<u>Brass clay</u>	<u>200</u>	<u>300</u>
(3) static water level (feet) <u>117</u> below above ground.	<u>gas shale</u>	<u>300</u>	<u>365'</u>
(4) casing <u>PVC, 174'</u> (material) (depth)			
<u>2"</u> (size) if telescope see back.			
(5) screen <u>15'</u> , <u>174'</u> (length) (depth to top)			
<u>1/2"</u> , <u>Aluminum</u> (size) (material)			
(6) pump <u>1 1/2</u> <u>5</u> (HP) (yield gpm)			
<u>Jet</u> (type power)			
(7) electric log <u>yes</u> (yes or no)			
<u>E. H. S. S.</u> (organization running log)			
(8) how well bottom plugged <u>Block</u>			
DRILLERS REMARKS:			


CODED

RECEIVED
OCT 21 1974

MISSISSIPPI BOARD OF WATER COMMISSIONERS

If well telescopes please sketch and show depths.

GROUND LEVEL

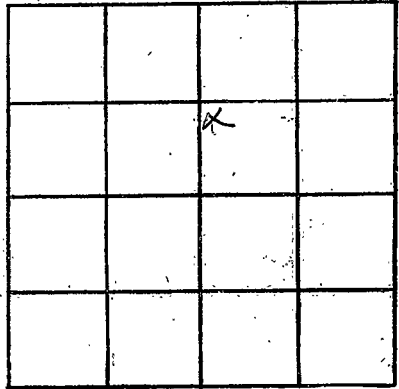

SECTION 26

Please indicate well location X.

ADDITIONAL INFORMATION

If more than one screen, show locations of each on sketch.