

HINDS
K48
7-24-75
Flg # 568

MISSISSIPPI
BOARD OF WATER COMMISSIONERS
416 North State Street
Jackson, Mississippi 39201

WATER WELL DRILLERS LOG CODED

724 1975 SACK GUMMER HINDS
date well completed firm name county well located

LANDOWNER:

DR. MORAN
MORAN
(mailing address)

description of formations encountered

from to

CLAY 0 110
NO CLAY 110 153
SAND 153 168

WELL LOCATION:

sec 22 T. 5 N R. 3 E
S W
(distance) miles (direction) of (nearest town)

WELL PURPOSE:

(home, irrigation, municipal, industrial)

WELL COMPLETION DATA:

- (1) diameter (inches) 4
- (2) total depth (feet) 168
- (3) static water level (feet) 4 below above top of ground.
- (4) casing T&C, 15d (material), (depth)
- 4 (size) if telescope see back.
- (5) screen 10 158 (length), (depth to top)
- 2 55 (size), (material)
- (6) pump 1 10 (HP), (yield gpm)
- MPC (type power)
- (7) electric log YES (yes or no)
- MCS (organization running log)
- (8) how well bottom plugged BWC


CODED

DRILLERS REMARKS:

MISSISSIPPI BOARD OF WATER COMMISSIONERS
JULY 29 1975
COMM

If well telescopes please sketch and show depths.

GROUND LEVEL

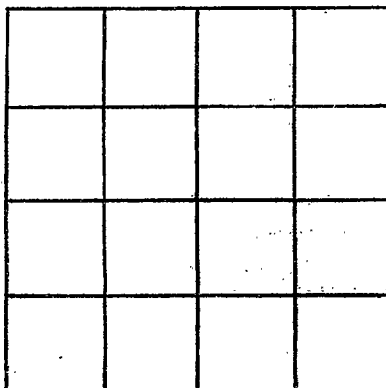

SECTION _____

Please indicate well location X.

ADDITIONAL INFORMATION

If more than one screen, show locations of each on sketch.