

HINDS
K56
4-15-76
Log #582

MISSISSIPPI
BOARD OF WATER COMMISSIONERS
416 North State Street
Jackson, Mississippi 39201
WATER WELL DRILLERS LOG

CODED

4/15 1976 Jack Quinn Hinds
date well completed firm name county well located

LANDOWNER: Temple Cartwright
Rapswood, Ms.

description of formations encountered	from	to
Clay	1	120
Rock	121	160
Sand	161	180
Clay	181	203

(mailing address)

WELL LOCATION:
sec. 22 T 5 N R 3 E
4 miles W of Rapswood
(distance) (direction) (nearest town)

WELL PURPOSE: Home
(home, irrigation, municipal, industrial)

- WELL COMPLETION DATA:
- (1) diameter (inches) 4"
 - (2) total depth (feet) 203'
 - (3) static water level (feet) 100' below top of ground.
 - (4) casing PVC 160' (material) (depth)
4" (size) if telescope see back.
 - (5) screen 20' 180' (length) (depth to top)
2" Stainless Steel (size) (material)
 - (6) pump 1/2 10 (HP) (yield gpm)
electricity (type power)
 - (7) electric log YES (yes or no)
Miss. Geological Survey (organization running log)
 - (8) how well bottom plugged

CODED

RECEIVED IN THE OFFICE OF THE SECRETARY OF THE MISSISSIPPI BOARD OF WATER COMMISSIONERS


APR 20 1976

DRILLERS REMARKS:

MISSISSIPPI BOARD OF WATER COMMISSIONERS

If well telescopes please sketch and show depths.

GROUND LEVEL

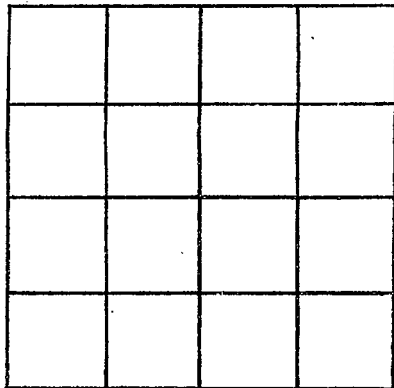

SECTION _____

Please indicate well location X.

ADDITIONAL INFORMATION

If more than one screen,
show locations of each on sketch.