

Hinds
K51
4-8-76
Log # 583

MISSISSIPPI
 BOARD OF WATER COMMISSIONERS
 416 North State Street
 Jackson, Mississippi 39201

WATER WELL DRILLERS LOG CODED

4/8 1976 Jack Guinn Hinds
 date well completed firm name county well located

LANDOWNER: R. E. Mordy
Raymond, Ms.
 (mailing address)

description of formations encountered	from	to
<u>Clay</u>	<u>1</u>	<u>160</u>
<u>Rock</u>	<u>161</u>	<u>213</u>
<u>Sand</u>	<u>214</u>	<u>240</u>
<u>Clay</u>	<u>241</u>	<u>262</u>

WELL LOCATION:
 sec. 28 T 5 N R 3 E
8 miles W of Raymond
 (distance) (direction) (nearest town)

WELL PURPOSE: Home
 (home, irrigation, municipal, industrial)

- WELL COMPLETION DATA:
- diameter (inches) 4"
 - total depth (feet) 262'
 - static water level (feet) 60 below ~~at~~ top of ground.
 - casing PVC, 213'
 (material) (depth)
4" if telescope see back.
 (size)
 - screen 20', 233'
 (length) (depth to top)
2", Stainless Steel
 (size) (material)
 - pump 1, 30
 (HP) (yield gpm)
electricity
 (type power)
 - electric log Yes
 (yes or no)
Miss. Geological Survey
 (organization running log)
 - how well bottom plugged _____

LOG CODED


MISSISSIPPI
 BOARD OF WATER COMMISSIONERS
 APR 20 1976

DRILLERS REMARKS: _____

MISS. BU. OF WATER COM. 11

If well telescopes please sketch and show depths.

GROUND LEVEL

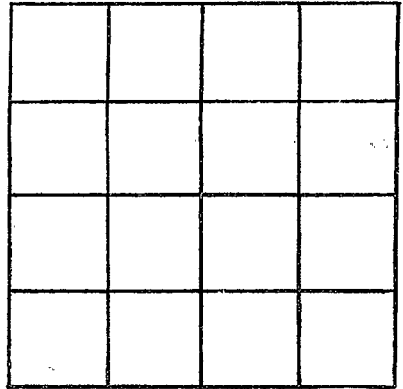

SECTION _____

Please indicate well location X.

ADDITIONAL INFORMATION

If more than one screen,
show locations of each on sketch.