

HINDS
K54
11/11/77
Log #620

MISSISSIPPI
BOARD OF WATER COMMISSIONERS
416 North State Street
Jackson, Mississippi 39201

WATER WELL DRILLERS LOG

CODED

11/11 1977 Jerry Guinn Hinds
date well completed firm name county well located

LANDOWNER: B. G. Solie

Raymond, Ms.

(mailing address)

description of formations encountered

from to

Clay	1	80
Rock	81	124
Sand	125	144
Clay	145	180

WELL LOCATION:

sec. 22 T. 5 N R. 3 E
5 miles W of Raymond
(distance) (direction) (nearest town)

WELL PURPOSE: HOME
(home, irrigation, municipal, industrial)

WELL COMPLETION DATA:


CODED

- diameter (inches) 4"
- total depth (feet) 180
- static water level (feet) 90 below top of ground.
- casing PVC, 124' (material) (depth)
4" (size) if telescope see back.
- screen 20' 144' (length) (depth to top)
4" PVC (size) (material)
- pump 1/2 7 (HP) (yield gpm)
Electricity (type power)
- electric log Yes (yes or no)
Ms. Geological Survey (organization running log)
- how well bottom plugged

DRILLERS REMARKS:

If well telescopes please sketch and show depths.

GROUND LEVEL

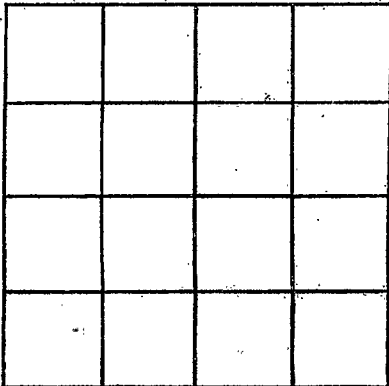

SECTION _____

Please indicate well location X.

ADDITIONAL INFORMATION

If more than one screen, show locations of each on sketch.