

MISSISSIPPI DEPARTMENT OF NATURAL RESOURCES

Bureau of Land and Water Resources

Southport Mall

P.O. Box 10631

Jackson, Mississippi 39209

WATER WELL DRILLERS LOG

*Grinn Water Well Serv.*

**CODED**

HINDS
K56
3-78
Flg #628

date well completed March 19 78 firm name ~~J. Easterwood~~ county well located Hinds

LANDOWNER: <u>J. Easterwood</u>	description of formations encountered	from	to
(mailing address)			
WELL LOCATION: sec. <u>26</u> T <u>5</u> N R. <u>3</u> <del>E</del> W _____ miles _____ of _____ (distance) (direction) (nearest town)			
WELL PURPOSE: (home, irrigation, municipal, industrial)			
WELL COMPLETION DATA: (1) diameter (inches) <u>4"</u> (2) total depth (feet) <u>325</u> (3) static water level (feet) <u>100</u> below above top of ground. (4) casing <u>4"</u> _____ (material) (depth) _____ if telescope see back. (size) (5) screen <u>20'</u> <u>180</u> (length) (depth to top) <u>4"</u> <u>PVC</u> (size) (material) (6) pump <u>3/4</u> <u>10</u> (HP) (yield gpm) <u>Elec.</u> (type power) (7) electric log <u>yes</u> (yes or no) <u>MGS</u> (organization running log) (8) how well bottom plugged <u>BPV</u>			
DRILLERS REMARKS:			

**CODED**


DEPT. OF NATURAL RESOURCES  
BUREAU OF LAND & WATER RESOURCES

SEP 30 1978

**RECEIVED**

If well telescopes please  
sketch and show depths.

GROUND LEVEL

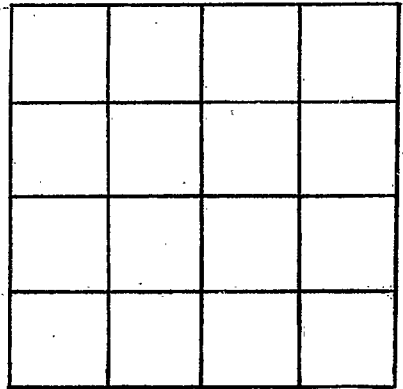

SECTION \_\_\_\_\_

Please indicate well location X.

ADDITIONAL INFORMATION

If more than one screen,  
show locations of each on sketch.