

HINDS
K58
6/20/78
ELW #632

MISSISSIPPI
BOARD OF WATER COMMISSIONERS
416 North State Street
Jackson, Mississippi 39201

CODED

WATER WELL DRILLERS LOG

6-20
date well completed

1978 E.M. "Bud" Kresswell
firm name

Hinds
county well located

LANDOWNER:
Ben L. Johnson
JACKSON, MS.
(mailing address)

description of formations encountered	from	to
Clay	0	80
Clay - thin - shale	80	210
Shaly - shale	210	260
Clay	260	275
Sand - sea shells	275	295
Shale	295	299
Sandy - shale	299	1090
Sand & streaks shale	1090	1120

WELL LOCATION:
sec. 23 T 5 N R 3 E
2 miles West of Raymond
(distance) (direction) (nearest town)

WELL PURPOSE: Home
(home, irrigation, municipal, industrial)

- WELL COMPLETION DATA:
- (1) diameter (inches) 4 x 2 1/2
 - (2) total depth (feet) 1120
 - (3) static water level (feet) 145 below top of ground.
 - (4) casing Steel, 1100 (material) (depth)
4 (size) if telescope see back.
 - (5) screen 20, 1100 (length) (depth to top)
2, stainless (size) (material)
 - (6) pump 3, 30 (HP) (yield gpm)
0 (type power)
 - (7) electric log yes (yes or no)
State (organization running log)
 - (8) how well bottom plugged
steel plugs

CODED


RECEIVED
JUL 19 1978

MISS. BD. OF WATER COMMISSIONERS

DRILLERS REMARKS:
400 ft. 4"
below 2 1/2" pipe

If well telescopes please sketch and show depths.

GROUND LEVEL

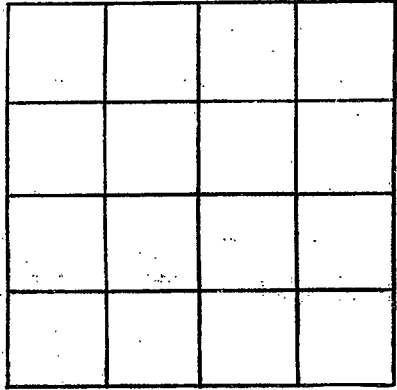

SECTION _____

Please indicate well location X.

ADDITIONAL INFORMATION

If more than one screen, show locations of each on sketch.