

HINDS  
K59  
4/27/79

MISSISSIPPI  
BOARD OF WATER COMMISSIONERS  
416 North State Street  
Jackson, Mississippi 39201

WATER WELL DRILLERS LOG

4/27 date well completed  
R. M. "Bud" Cresswell firm name  
Hinds county well located

LANDOWNER:  
Ben Johnson  
JACKSON, MS.  
(mailing address)

WELL LOCATION:  
sec. 27 T 4 N R 1 E W 3  
2 miles 5 of BYRAM  
(distance) (direction) (nearest town)

description of formations encountered

from to

No record  
Electric log by State  
Geological Survey

WELL PURPOSE: home  
(home, irrigation, municipal, industrial)

WELL COMPLETION DATA:

(1) diameter (inches) 4

(2) total depth (feet) approx 280

(3) static water level (feet) 135 below top of ground

(4) casing PVC 270 (material), (depth)  
4 (size) if telescope see back.

(5) screen 10 270 (length), (depth to top)  
4 PVC (size) (material)

(6) pump 1 1/2 25 (HP), (yield gpm)  
0 (type power)

(7) electric log yes (yes or no)  
Ms. State Geol. Survey (organization running log)

(8) how well bottom plugged  
Steel plug

Miss. Board of Water Comm.


MAY 24 1979

RECEIVED

DRILLERS REMARKS:  
Lost drillers log and have contacted state to send me a copy of log but have not received it yet.

If well telescopes please sketch and show depths.

GROUND LEVEL

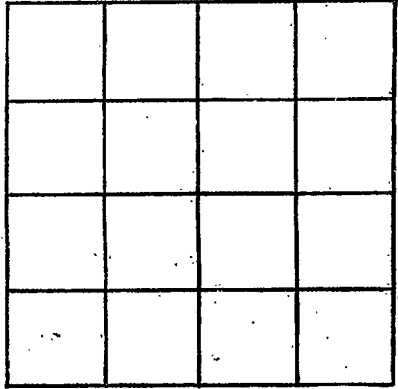

SECTION \_\_\_\_\_

Please indicate well location X.

ADDITIONAL INFORMATION

If more than one screen, show locations of each on sketch.