

MISSISSIPPI DEPARTMENT OF NATURAL RESOURCES

Bureau of Land and Water Resources

P.O. Box 10631

Jackson, Mississippi 39209

WATER WELL DRILLERS LOG

COUNTY WELL LOCATED Hinds	
WELL NUMBER R 75	CODED <input checked="" type="checkbox"/>
DATE WELL COMPLETED 12-18-98	

PERMIT NUMBER 510
NAME OF DRILLING FIRM Easley Waterwell
Brookhaven, MS 39601

NAME & MAILING ADDRESS OF LANDOWNER Neal Strickland			
WELL LOCATION:	SEC	TOWNSHIP	RANGE
	27	5	3
		N	E
DISTANCE	DIRECTION	NEAREST TOWN	
_____ Miles	_____ of	_____	
OTHER LANDMARK			
WELL PURPOSE: Home, Irrigation, Municipal, Industrial, Fish Pond, etc.			

PUMP DATA		
PUMP TYPE (Circle One): Submersible, Turbine, Jet, Flowing Well, Other (Describe) _____		
POWER TYPE (Circle One): Electric, Tractor, Diesel, Gasoline, Butane, Other (Describe) _____		
Pump Capacity (GPM)	No. of Stages	Setting Depth FT.
PUMP TEST		
Well yielded _____ GPM with a drawdown of _____ ft. after _____ hours of pumping		


WELL DATA		
Well Depth 237'	Casing Diameter (In.) 4"	Casing Length (Ft.) 217'
Type of Casing PVC	Hole Depth 324'	Depth to Static Water Level
TYPE OF COMPLETION: (Circle One or More): Gravel Packed, Underreamed, Telescoped, Natural Development , Open Hole, Other (Describe) _____		
Top of Lap Pipe or Reduction in Casing FEET IF TELESCOPED OR MORE THAN ONE SCREEN: USE BACK PAGE		

LOG DATA	
TYPE OF LOG RUN (Circle One): Electric , Gamma Ray, Density, Sonic, Neutron, Other (Describe) _____	
Name of Organization Running Log	

SCREEN DATA		
Diameter - Inches 4"	Length - Feet 20'	Slot Size - Inches 008
Screen Type PVC	Depth to Bottom - Feet	

GEOLOGIC DATA (Office Use Only)			
Surface Elev.	Geologic Unit	Unit Thickness	Depth to Top
Subs. SWL	Date	Analysis	Aquifer Test
Driller's Remarks			

DESCRIPTION OF FORMATIONS ENCOUNTERED	FROM	TO
Clay	0	90
Rock	90	140
Clay	140	217
Sand	217	237
Clay	237	324

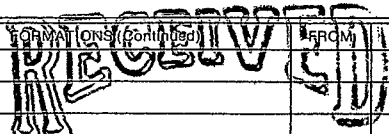

**Dept. of Environmental Quality
Office of Land & Water Resources**

IF MORE SPACE IS NEEDED, USE BACK

