

HINDS
K 2000
7-13-62

WATER WELL DRILLERS LOG

Forest Drilling

Date: 7/9 to 7/13, 1962, Driller: Johnnie Beasley County: Hinds
(Name)


(1) Owner of Land: T. D. Jayroe
(Name)
Jackson, Miss.
(Address)
This well located South of Jackson
(2) Location: 1/4, 1/4, Sec. 15 N 24
on Hwy. 18. Go below Raymond to
Siwell Groe, turn right for about
2 miles. Well on left.
(distance) (direction) (Nearest Town)
(3) Topography: X
(Hilly) (Flat) (Level)
(4) Purpose of Well: Domestic. Home
(Domestic Irrigation
Municipal, Industrial, Other)

Description & Color of Materials Sand, Clay, Red Clay, Shell, etc.	Thick- ness Feet	Depth Feet
Brown clay & silt.	32-	32
Blue clay.	20-	52
Shale & stks. lime.	6-	58
Lime rock & stks. shale.	62-	120
Fine sand.	5-	125
Shale & blue clay.	39-	164
Blue clay, lime & sand.	18-	182
Blue clay & stks. silt.	63-	245
Blue clay.	330-	575
Blue shale.	21-	596
Shale.	53-	649
Lime & shale.	10-	659
Shale.	87-	746
Shale & stks. silt.	24-	770
Shale & stks. sand.	40-	810
Fine sand.	41-	851
Sand. (Screen setting.)	20-	871

Information upon completion of well:

(1) Diameter 2 inches.
(2) Total Depth 871 feet.
(3) Water Level 160 feet below top of ground.
(4) Cased to 861', Size 2"
(5) Screen: Size 2", Length 10'
(6) Were any formations sealed against pollution?
no.

If YES depth of formation _____
Why _____
Drillers Remarks: Good well.

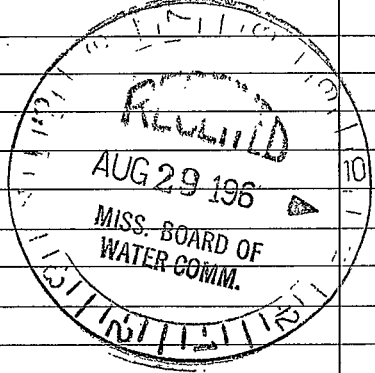

FOREST DRILLING SERVICE
P. O. Box 5717
PEARL BRANCH
JACKSON 8, MISS.

Retain this copy for your office files.

(Use Back Side)

Well No.