

HINDS

MISSISSIPPI BOARD OF WATER COMMISSIONERS

K 2002

3-17-64

WATER WELL DRILLERS LOG

Date: 3-17-64, Driller: James McNeese County: Hinds

(Name)

(1) Owner of Land: E. H. Goode (Name)

Raymond Miss (Address)

(2) Location: 1/4, 1/4, Sec. T 31 N R 30 W

6 miles West Raymond (distance) (direction) (Nearest Town)

(3) Topography: (Hilly) (Flat) (Level)

(4) Purpose of Well: Domestic & Home (Domestic Irrigation, Municipal, Industrial, Other)

Description & Color of Materials Sand, Clay, Red Clay, Shell, etc.	Thick- ness Feet	Depth Feet
Surface soil	20	20
clay	20	40
Blue shale	35	75
Grey sh - Limp Fossils	27	122
Rock - sh str	44	166
Grey sh	5	171
Sand - sh. Fossils	30	201
Grey sh	16	217
Grey sh sd str	17	234
Grey sh	83	317
9 1/2" 2"	171	
2-5' 1 1/4" screens	10	
	181	

Information upon completion of well:

(1) Diameter: 2 inches.

(2) Total Depth: 317 feet.

(3) Water Level: 112 feet below top of ground.

(4) Cased to: 171' 181' Size


(5) Screen: Size 1 1/4", Length 10

(6) Were any formations sealed against pollution? yes, no.

If YES depth of formation

Why

Drillers Remarks:

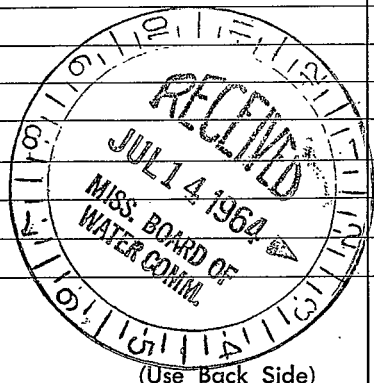

Well No.