

MISSISSIPPI DEPARTMENT OF NATURAL RESOURCES

Bureau of Land and Water Resources

P.O. Box 10631

Jackson, Mississippi 39209

WATER WELL DRILLERS LOG

COUNTY WELL LOCATED Hinds	
WELL NUMBER R 2004	CODED
DATE WELL COMPLETED 5-24-96	

PERMIT NUMBER 510
NAME OF DRILLING FIRM Easley Water Wells
Brookhaven, MS 39601

NAME & MAILING ADDRESS OF LANDOWNER Linton Terrell			
WELL LOCATION:	SEC. 10	TOWNSHIP 5 S	RANGE 3 W
DISTANCE _____ Miles	DIRECTION _____	NEAREST TOWN _____	
OTHER LANDMARK _____			
WELL PURPOSE: Home, Irrigation, Municipal, Industrial, Fish Pond, etc.			

PUMP DATA		
PUMP TYPE (Circle One): <input checked="" type="checkbox"/> Submersible, Turbine, Jet, Flowing Well, Other (Describe) _____		
POWER TYPE (Circle One): <input checked="" type="checkbox"/> Electric, Tractor, Diesel, Gasoline, Butane, Other (Describe) _____		
Pump Capacity (GPM)	No. of Stages	Setting Depth _____ FT.
PUMP TEST		
Well yielded _____ GPM with a drawdown of _____ ft. after _____ hours of pumping		


WELL DATA		
Well Depth 170'	Casing Diameter (In.) 4"	Casing Length (Ft.) 150
Type of Casing PVC	Hole Depth 170	Depth to Static Water Level
TYPE OF COMPLETION: (Circle One or More): <input checked="" type="checkbox"/> Gravel Packed, Underreamed, Telescoped, <input checked="" type="checkbox"/> Natural Development, Open Hole, Other		
Top of Lap Pipe or Reduction in Casing FEET IF TELESCOPED OR MORE THAN ONE SCREEN: USE BACK PAGE		

LOG DATA	
TYPE OF LOG RUN (Circle One): <input type="checkbox"/> No Log Run, Electric, Gamma Ray, Density, Sonic, Neutron, Other (Describe) _____	
Name of Organization Running Log _____	

SCREEN DATA		
Diameter - Inches 4"	Length - Feet 20	Slot Size - Inches 8
Screen Type pvc	Depth to Bottom - Feet 170	

GEOLOGIC DATA (Office Use Only)			
Surface Elev.	Geologic Unit	Unit Thickness	Depth to Top
Subs. SWL	Date	Analysis	Aquifer Test

Driller's Remarks

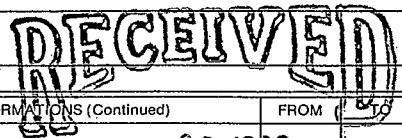

DESCRIPTION OF FORMATIONS ENCOUNTERED	FROM	TO	FORMATIONS (Continued)	FROM
Clay	0	100		
Rock	100	150		
SAND	150	170		

**DEPT. OF ENVIRONMENTAL QUALITY
OFFICE OF LAND & WATER RESOURCES**

JUL 02 1996

IF MORE SPACE IS NEEDED, USE BACK

If well telescopes please
sketch and show depths.

GROUND LEVEL

SECTION _____

Please indicate well location X.

ADDITIONAL INFORMATION

If more than one screen,
show location of each on sketch.