

MISSISSIPPI DEPARTMENT OF NATURAL RESOURCES

Bureau of Land and Water Resources

P.O. Box 10631

Jackson, Mississippi 39209

WATER WELL DRILLERS LOG

COUNTY WELL LOCATED Hinds	
WELL NUMBER 77182	CODED
<i>R 2005</i>	
DATE WELL COMPLETED 5-23-96	

PERMIT NUMBER 510
NAME OF DRILLING FIRM Easley Water Wells
Brookhaven, MS 39601

NAME & MAILING ADDRESS OF LANDOWNER William R. Stell			
WELL LOCATION:	SEC	TOWNSHIP	RANGE
	10	5N S	3W EW
DISTANCE	DIRECTION	NEAREST TOWN	
_____ Miles	_____ of _____	_____	
OTHER LANDMARK			
WELL PURPOSE: Home, Irrigation, Municipal, Industrial, Fish Pond, etc.			

PUMP DATA		
PUMP TYPE (Circle One): <input checked="" type="radio"/> Submersible Turbine, Jet Flowing Well, Other (Describe) _____		
POWER TYPE (Circle One): <input checked="" type="radio"/> Electric Tractor, Diesel, Gasoline, Butane, Other (Describe) _____		
Pump Capacity (GPM)	No. of Stages	Setting Depth FT.
PUMP TEST		
Well yielded _____ GPM with a drawdown of _____ ft. after _____ hours of pumping		

WELL DATA		
Well Depth 216' 176	Casing Diameter (In.) 4"	Casing Length (Ft.) 156
Type of Casing PVC	Hole Depth 216	Depth to Static Water Level
TYPE OF COMPLETION: (Circle One or More): <input checked="" type="checkbox"/> Gravel Packed, <input type="checkbox"/> Underreamed, <input type="checkbox"/> Telescoped, <input checked="" type="checkbox"/> Natural Development, <input type="checkbox"/> Open Hole, <input type="checkbox"/> Other (Describe) _____		
Top of Lap Pipe or Reduction in Casing		
FEET IF TELESCOPED OR MORE THAN ONE SCREEN: USE BACK PAGE		

LOG DATA	
TYPE OF LOG RUN (Circle One): No Log Run, Electric, Gamma Ray, Density, Sonic, Neutron, Other (Describe) _____	
Name of Organization Running Log	

SCREEN DATA		
Diameter - Inches 4"	Length - Feet 20	Slot Size - Inches #08
Screen Type PVC	Depth to Bottom - Feet 176	

GEOLOGIC DATA (Office Use Only)			
Surface Elev.	Geologic Unit	Unit Thickness	Depth to Top
Subs. SWL	Date	Analysis	Aquifer Test

Driller's Remarks

RECEIVED

DESCRIPTION OF FORMATIONS ENCOUNTERED	FROM	TO	FORMATIONS (Continued)	
			FROM	TO
Clay	0	120		
Rock	120	160		
SAND	160	176		
Clay	176	216		


JUL 02 1996

**Dept. of Environmental Quality
Office of Land & Water Resources**

IF MORE SPACE IS NEEDED, USE BACK

If well telescopes please
sketch and show depths.

GROUND LEVEL

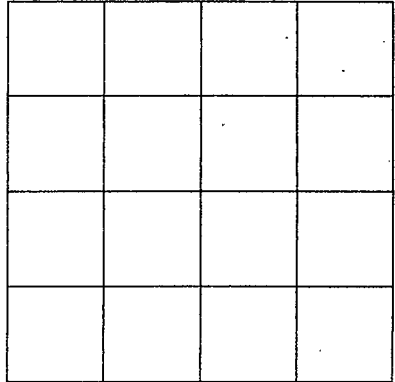

SECTION _____

Please indicate well location X.

ADDITIONAL INFORMATION

If more than one screen,
show location of each on sketch.