

HINDS

MISSISSIPPI BOARD OF WATER COMMISSIONERS

L30

6-15-65

WATER WELL DRILLERS LOG

CODED

Date: June 15, 1965, Driller: Layne-Central Co. Hinds County

E Log 198 USGS

(Name)

(1) Owner of Land: Town of Raymond, (Name) Raymond, Mississippi (Address)

(2) Location: 1/4, 1/4, Sec 21 52 T12R1E, NW SW SW miles (distance) of (direction) (Nearest Town)

(3) Topography: (Hilly) (Flat) (Level)

(4) Purpose of Well: municipal (Domestic Irrigation Municipal, Industrial, Other)

Information upon completion of well:

(1) Diameter 12 inches.

(2) Total Depth 1168 feet.

(3) Water Level 165' feet below top of ground.

(4) Cased to 1095', Size 12"

(5) Screen: Size 8", Length 60'


(6) Were any formations sealed against pollution? X yes, no.

If YES depth of formation 1095'

Why required

Drillers Remarks:

Description & Color of Materials Sand, Clay, Red Clay, Shell, etc.	Thick- ness Feet	Depth Feet
sandy clay	15	15
white clay	13	28
blue clay-hard	75	103
soft clay	42	145
sandy clay	19	164
rock	3	167
limerock-hard	15	182
soft lime	4	186
lime rock	7	193
fine sand-stks hard lime	101	294
fine sand	98	392
clay	15	407
sandy clay-stks sand	57	464
clay	26	490
sandy shale	35	525
hard clay	295	820
sandy shale-stks sand	113	933
sandy shale	67	1000
gummy shale	75	1075
sandy shale	17	1092
pk sand	76	1168
fine sand-shale	23	1191

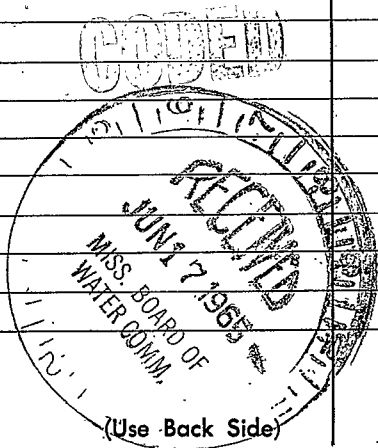

Well No.