

HINDS

MISSISSIPPI BOARD OF WATER COMMISSIONERS

L-32 Electrical LOG MISSISSIPPI GEOLOGICAL SURVEY

WATER WELL DRILLERS LOG

8-5-65

Date: 8-5-65, 1965, Driller: James McNeese County Hinds

(Name)

(1) Owner of Land: James Prewitt  
(Name)  
JACKSON MISS  
(Address)

(2) Location: SE 1/4, SE 1/4, Sec. 1 T5 R2 W  
\_\_\_\_\_ miles \_\_\_\_\_ of \_\_\_\_\_  
(distance) (direction) (Nearest Town)

(3) Topography:  (Hilly)  (Flat)  (Level)

(4) Purpose of Well: Domestic  
(Domestic Irrigation  
Municipal, Industrial, Other)

Description & Color of Materials Sand, Clay, Red Clay, Shell, etc.	Thick- ness Feet	Depth Feet
SURFACE SOIL	10	10
Clay	20	30
SAND	30	60
Grey shale	90	150
Grey sdy shale	5	155
SAND	8	163
SANDY SH SAND STRKS	87	250
Grey shale	3	253
SAND-SH STRKS	17	270
Grey shale	345	615
Sdy sh	20	635
Grey sh STRKS Sdy sh	120	755
ROCK	1	756
Sdy sh	2	758
ROCK	6	764
Sdy sh	14	778
SAND	52	830
Grey sh	3	833
SAND	9	842
ROCK	1	843
shale	2	845
ROCK	1	846
SAND	12	858
SAND SH STRKS	27	885
ROCK	1	886
Grey sh sd STRKS	22	908
SAND	23	931
SH SD STRKS	8	939
SAND	26	975
SH-	23	998
ROCK	21	999
Sdy sh	42	1041

Information upon completion of well:

(1) Diameter 4" x 2" inches.

(2) Total Depth 1041 feet.

(3) Water Level 183 feet below top of ground.

(4) Cased to 898, Size 4" x 2"

(5) Screen: Size 2" 008, Length 20'


(6) Were any formations sealed against pollution?

yes  no

If YES depth of formation 4" x 2" 1/6 JOINTS 9" 338'  
27 JOINTS 2" 559'

Why? 2" 008 SS screen 20'  
878'  
20'  
918'  
10'  
928'

water white

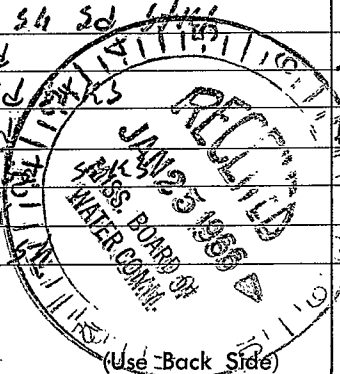

Well No.