

HINDS

MISSISSIPPI BOARD OF WATER COMMISSIONERS

ELOG #232

L34

Electrical Log - Misc. Geological Survey

10-14-65

WATER WELL DRILLERS LOG

CODED

Date: 10-14, 1965, Driller: James McNEES County: HINDS

(Name)

(1) Owner of Land: W.E. Williams
(Name)
North Midway Road Jackson
(Address)

(2) Location: SW 1/4, NE 1/4, Sec 23 T5 R2, N W
8 miles West of Jackson
(distance) (direction) (Nearest Town)

(3) Topography: (Hilly) (Flat) (Level)

(4) Purpose of Well: Domestic
(Domestic Irrigation
Municipal, Industrial, Other)

Description & Color of Materials Sand, Clay, Red Clay, Shell, etc.	Thick- ness Feet	Depth Feet
Surface soil	15	15
Clay	10	25
Blue shale	98	123
Grey shale	30	153
Grey sdy sh	10	163
Sand	97	260
Sand-Lignite	3	263
Sand	15	278
Sand shale	25	303
Sand	10	313
Grey sdy sh Lignite	40	353

Information upon completion of well:

(1) Diameter 2" inches.
(2) Total Depth 353 feet.
(3) Water Level 100' feet below top of ground.
(4) Cased to 294', Size 2"
(5) Screen: Size 2.008", Length 10'
(6) Were any formations sealed against pollution?
yes, no. no.


14 Jts 2"	294
1-2" .008 ss screen	10
	304
1-Jt 2" BPU	6
	310

If YES depth of formation _____

Why _____

Drillers Remarks:

Water White

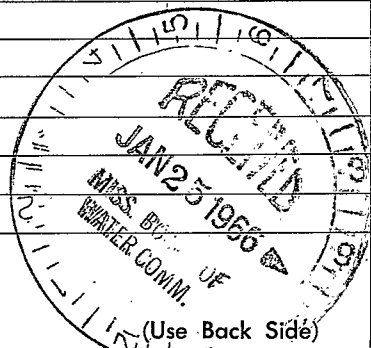

Well No.