

MISSISSIPPI
 BOARD OF WATER COMMISSIONERS CODED
 416 North State Street
 Jackson, Mississippi 39201

WATER WELL DRILLERS LOG

Hinds
 L 35
 2/67
 Elec Log
 2-23-67

McNees Drilling Co

Hinds

date well completed

firm name

county well located

LANDOWNER: Jack Bass

Clinton Miss

706 Berkshire
 (mailing address)

WELL LOCATION:

sec. 11 T-5 N R-2 W
 S W
 5 miles N.W. of JACKSON
 (distance) (direction) (nearest town)

WELL PURPOSE: Home
 (home, irrigation, municipal, industrial)

WELL COMPLETION DATA:

- (1) diameter (inches) 4" x 2"
- (2) total depth (feet) 287
- (3) static water level (feet) 50 below top of ground.
- (4) casing steel (material), (depth)

- (5) screen 10' 235-40 (size) if telescope see back.
 2' 249-54 (length) (depth to top)
 2" stainless steel (size) (material)

- (6) pump 1/2 15 GPM (HP) (yield gpm)


- Elec (type power)
- (7) electric log yes (yes or no)

- M-G-3- (organization running log)

- (8) how well bottom plugged mud

description of formations encountered

	from	to
surface soil	0	10
CLAY	10	30
Blue shale	30	70
ROCK	70	90
Grey shale	90	208
Grey sdy sh	208	238
SAND	238	243
Grey sdy sh	243	246
Grey sdy sh sdsks	246	267
Grey sh	267	287

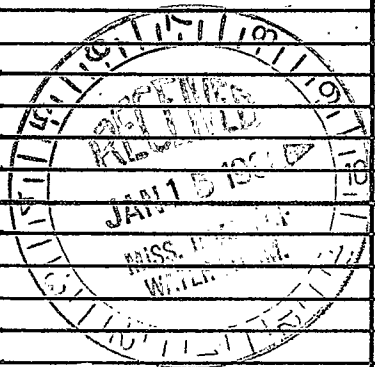


DRILLERS REMARKS:

clear water

If well telescopes please sketch and show depths.

GROUND LEVEL

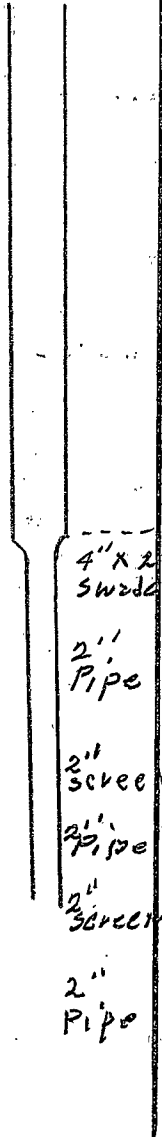

4' 210' 6"
4" X 2" SWD AC 1
211' 6"
2' Pipe 23' 6"
235' 0"
2' screen 6"
240'
2' pipe 9"
249'
2' screen 5"
254'
2' Pipe 7"
261'

X			

SECTION _____

Please indicate well location X.

ADDITIONAL INFORMATION

If more than one screen, show locations of each on sketch.