

Hinds
L 37
7-66

MISSISSIPPI BOARD OF WATER COMMISSIONERS

WATER WELL DRILLERS LOG CODED

Date: 7-21-, 1966, Driller: Layne-Central Co. County Hinds
(Name)

(1) Owner of Land: Town of Raymond
(Name)
Raymond, Mississippi
(Address)

(2) Location: 1/4, 30 5 2 Sec. T N E
3 E NW
_____ miles _____ of _____
(distance) (direction) (Nearest Town)

(3) Topography: _____
(Hilly) (Flat) (Level)

(4) Purpose of Well: Municipal
(Domestic Irrigation
Municipal, Industrial, Other)

Information upon completion of well:

(1) Diameter 12 inches.

(2) Total Depth 1259 feet.

(3) Water Level 130 feet below top of ground.


(4) Cased to 1187', Size 12"

(5) Screen: Size 8", Length 61' 10"

(6) Were any formations sealed against pollution?
x yes, _____ no.

If YES depth of formation 1187'
Why _____ required
Drillers Remarks: _____

Description & Color of Materials Sand, Clay, Red Clay, Shell, etc.	Thick-ness Feet	Depth Feet
sandy clay	12	12
white clay	33	45
brittle clay	17	62
clay	16	78
sand	9	87
black clay	63	150
rock	3	153
lime	2	155
rock	1	156
hard lime/sandy stks	21	177
rock	1	178
limey sand	112	290
sandy clay	90	380
clay	407	787
sandy shale	14	801
sand	8	809
sandy shale	41	850
fine sand-shale	53	903
sand(fine)-shale bks	16	919
sandy shale-stks fine sand	106	1025
fine sand	70	1165
fine sand-shale	15	1180
sand	78	1258
shale	4	1262

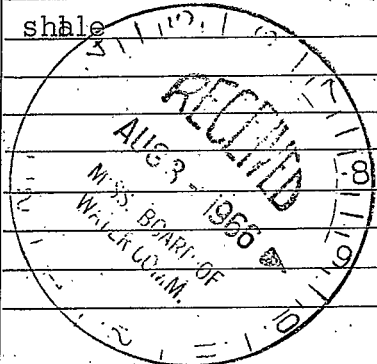

(Use Back Side)

Well No.