

HINDS

L38

9-22-70

MISSISSIPPI BOARD OF WATER COMMISSIONERS 416 North State Street Jackson, Mississippi 39201

CODED

WATER WELL DRILLERS LOG

9-22-1970 - James McNeese

Hinds

date well completed

firm name

county well located

LANDOWNER: Henry Waggoner

W. P. Tzylov

Rzymond Miss (mailing address)

WELL LOCATION:

sec 19 T 5 N R 2 E 3/4 miles south of Rzymond (distance) (direction) (nearest town)

WELL PURPOSE: Home (home, irrigation, municipal, industrial)

WELL COMPLETION DATA:

- (1) diameter (inches) 4" x 7"
(2) total depth (feet) 284'
(3) static water level (feet) 105 below top of ground.
(4) casing steel 244 (material) (depth)
(5) screen 16' 244 (length) (depth to top) 2" stainless steel (size) (material)
(6) pump 3/4 (HP) 10 (yield gpm) Elec (type power)
(7) electric log Yes (yes or no) M.G.S. (organization running log)

Table with 4 columns: description of formations encountered, from, to. Rows include: SURFACE SOIL (0-15), CLAY (15-30), BLUE SHALE (30-84), BROWN SH (84-125), Grey Sdy Sh (125-146), SAND (146-156), shale limestone (156-228), Sdy Sh (228-244), SAND (244-249), Grey Sdy Sh (249-254), SAND (254-259), Grey Sdy Sh (259-264), Grey Sh (264-284).

Table with 4 columns: description of formations encountered, from, to. Rows include: 11 lbs 4" (225), 4" x 3" SWEGEE (1), 1-lt. 2" (18), 2" SCREEN (16).

CODED


NOV 5 1970

MISS. BD. OF WATER COMM.

DRILLERS REMARKS: Water - Does NOT have color

If well telescopes please sketch and show depths.

GROUND LEVEL

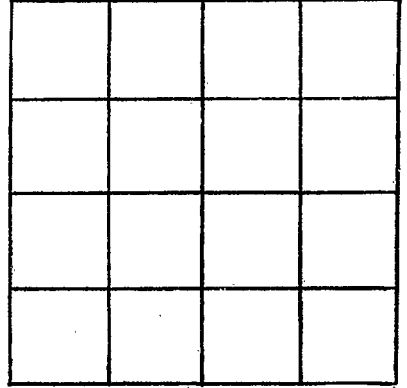

SECTION _____

Please indicate well location X.

ADDITIONAL INFORMATION

If more than one screen,
show locations of each on sketch.