

None on MGS log
 Robert Reynolds

Hinds
 L46
 4-72

MISSISSIPPI
 BOARD OF WATER COMMISSIONERS
 416 North State Street
 Jackson, Mississippi 39201

ELOG# 442

WATER WELL DRILLERS LOG

CODED

Hinds

April 19 72 date well completed
 Jack Martin firm name
 Hinds county well located

LANDOWNER:
 Roy Hudson
 Clinton
 (mailing address)

description of formations encountered	from	to
	clay	
limestone		6'

WELL LOCATION:
 sec. 1 T. 5 N. R. 2 W.
 4 miles S of Clinton
 (distance) (direction) (nearest town)

at 5' - 11' at 12' - 1 1/2' at 18'		
little sand & mud		18'
Mud		248'
bottom of 4" pipe		248'

WELL PURPOSE: Home
 (home, irrigation, municipal, industrial)

Mud (no sand visible)		595'
-----------------------	--	------

WELL COMPLETION DATA:

(1) diameter (inches) 4 x 2

(2) total depth (feet) 865

(3) static water level (feet) 178 below top of ground.

(4) casing Steel (material), 830 (depth)
 (size) if telescope see back.

(5) screen 35 (length), 835 (depth to top)
 2 (size), SS (material)

(6) pump 1 1/2 (HP), 15 (yield gpm)
 Ebee (type power)

(7) electric log yes (yes or no)
 Ms S. S. (organization running log)

(8) how well bottom plugged Plug

Shell - Mud - little sand	595'	720'
Mud (Hard Drill)	720'	770'
Fine Sand	770'	865'

CODED

MISS. RD. OF WATER MAIN

DRILLERS REMARKS: Fine sand - used 2 1/2" slot opening screen - sand produced good yield for fine sand - Drilled to 962 - 2 1/2" pipe under screen

If well telescopes please sketch and show depths.

GROUND LEVEL

246 4" lead seal
4x2


Pipe 24
from
238 to
830

930

865

2"

962

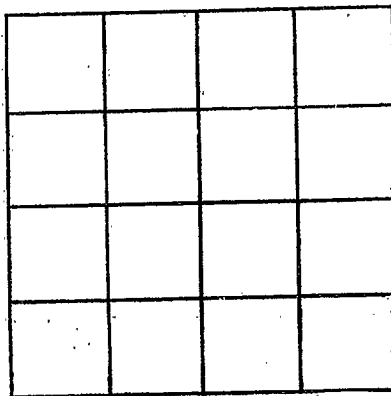

SECTION 1

Please indicate well location X.

ADDITIONAL INFORMATION

If more than one screen, show locations of each on sketch.